


EXHIBIT

C - Part II

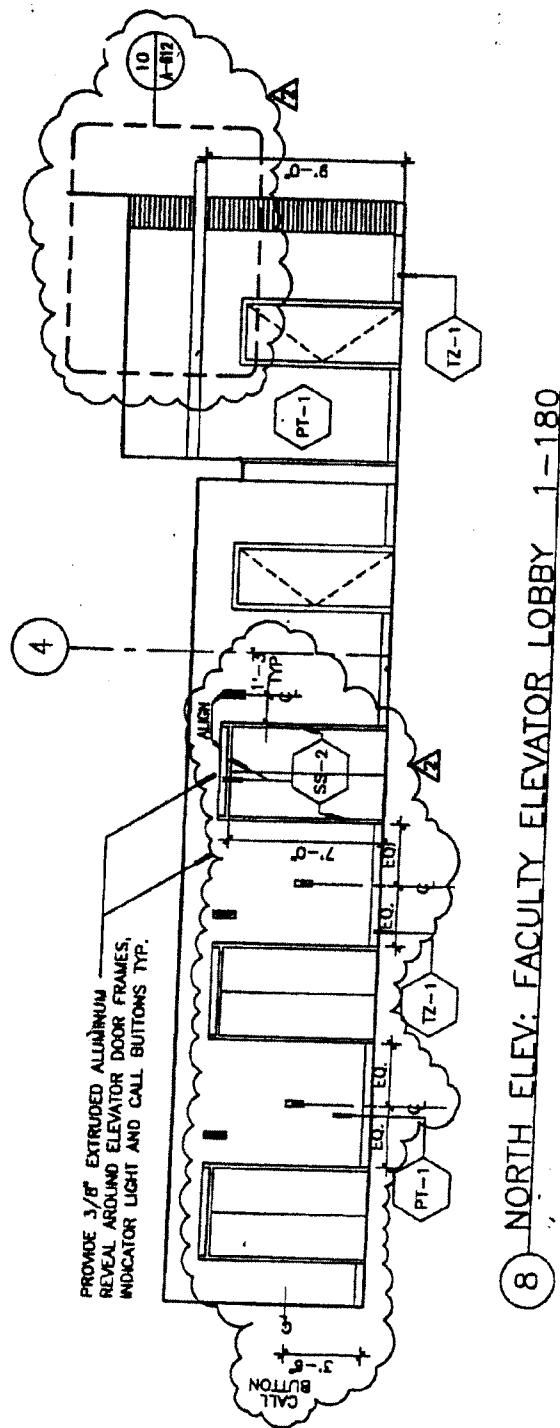

Baruch Academic Complex - Site B

55 LEXINGTON AVENUE NEW YORK, NY 10010


OWNER

DORMITORY AUTHORITY OF THE STATE OF NEW YORK, DA# 6500 1802 2176
1 PENNSYLVANIA PLAZA NEW YORK, NY 10119

ARCHITECT
KPF ASSOCIATES
111 WEST 57TH STREET
NEW YORK, NY 10019

REF. DETAIL/SHEET NO. 81A-528	SKETCH NO. 825
SCALE 1/8"	

NO.	REVISION	DATE
ADDENDUM #2 (CONTRACT #15)		3/3/98

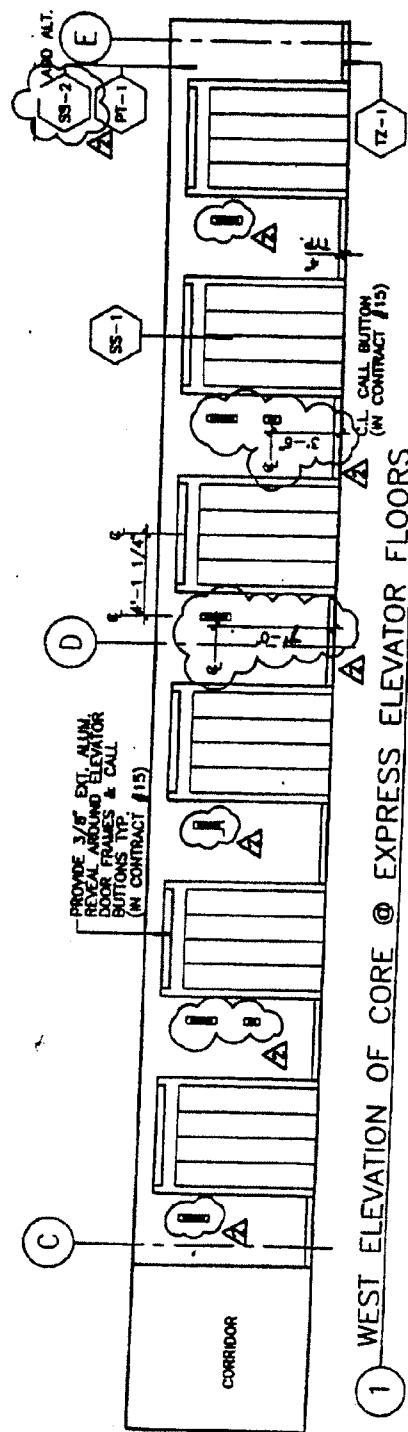

Baruch Academic Complex - Site B


55 LEXINGTON AVENUE NEW YORK, NY 10010

ARCHITECT
KPF ASSOCIATES
111 WEST 57TH STREET
NEW YORK, NY 10019

OWNER
DORMITORY AUTHORITY OF THE STATE OF NEW YORK, DA# 6500 1802 2176
1 PENNSYLVANIA PLAZA NEW YORK, NY 10119

REF. DETAIL/SHEET NO.
1/A - 545

NO.	REVISION	DATE	SKETCH NO.
	ADDENDUM #2 (CONTRACT #15)	3/3/98	826

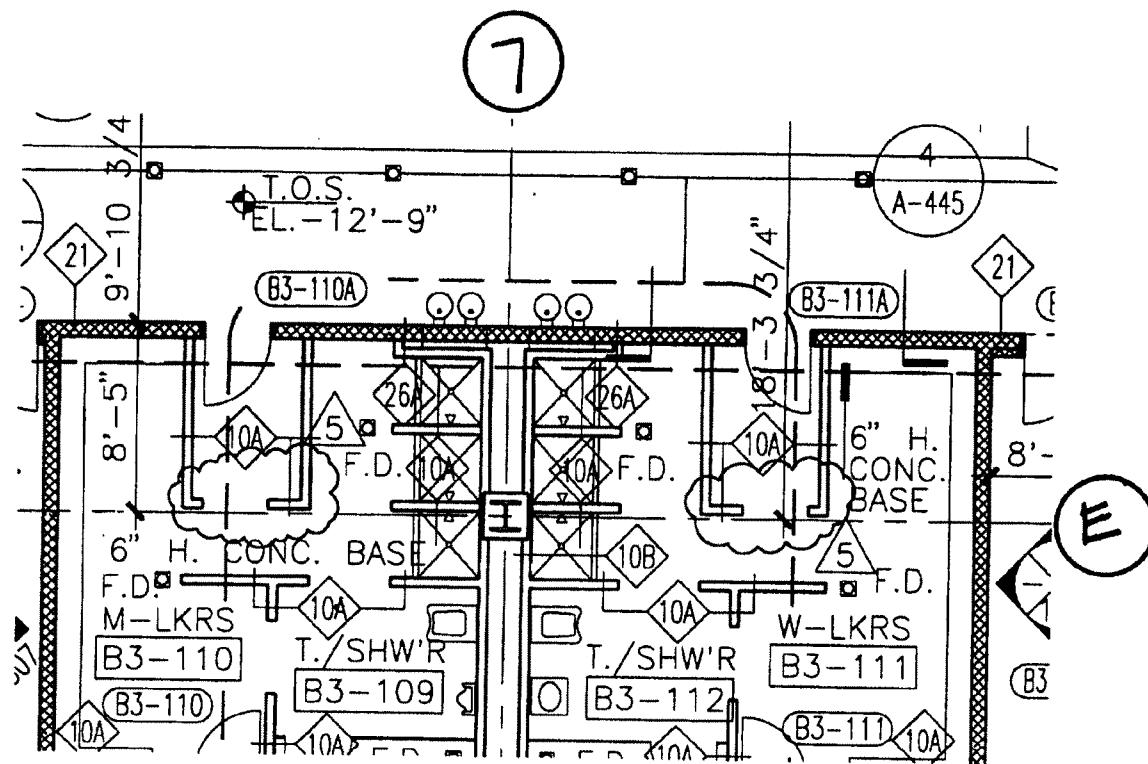

Baruch Academic Complex - Site B

55 LEXINGTON AVENUE NEW YORK, NY 10010


OWNER

DORMITORY AUTHORITY OF THE STATE OF NEW YORK, DA# 6500 1802 2176
1 PENNSYLVANIA PLAZA NEW YORK, NY 10119

ARCHITECT
KPF ASSOCIATES
111 WEST 57TH STREET
NEW YORK, NY 10019

REF. DETAIL/SHEET NO.	SKETCH NO.
A-101	827
SCALE $\frac{1}{8}'' = 10'$	

NO.	REVISION	DATE
	ADDENDUM #2 (CONTRACT #15)	3/3/98

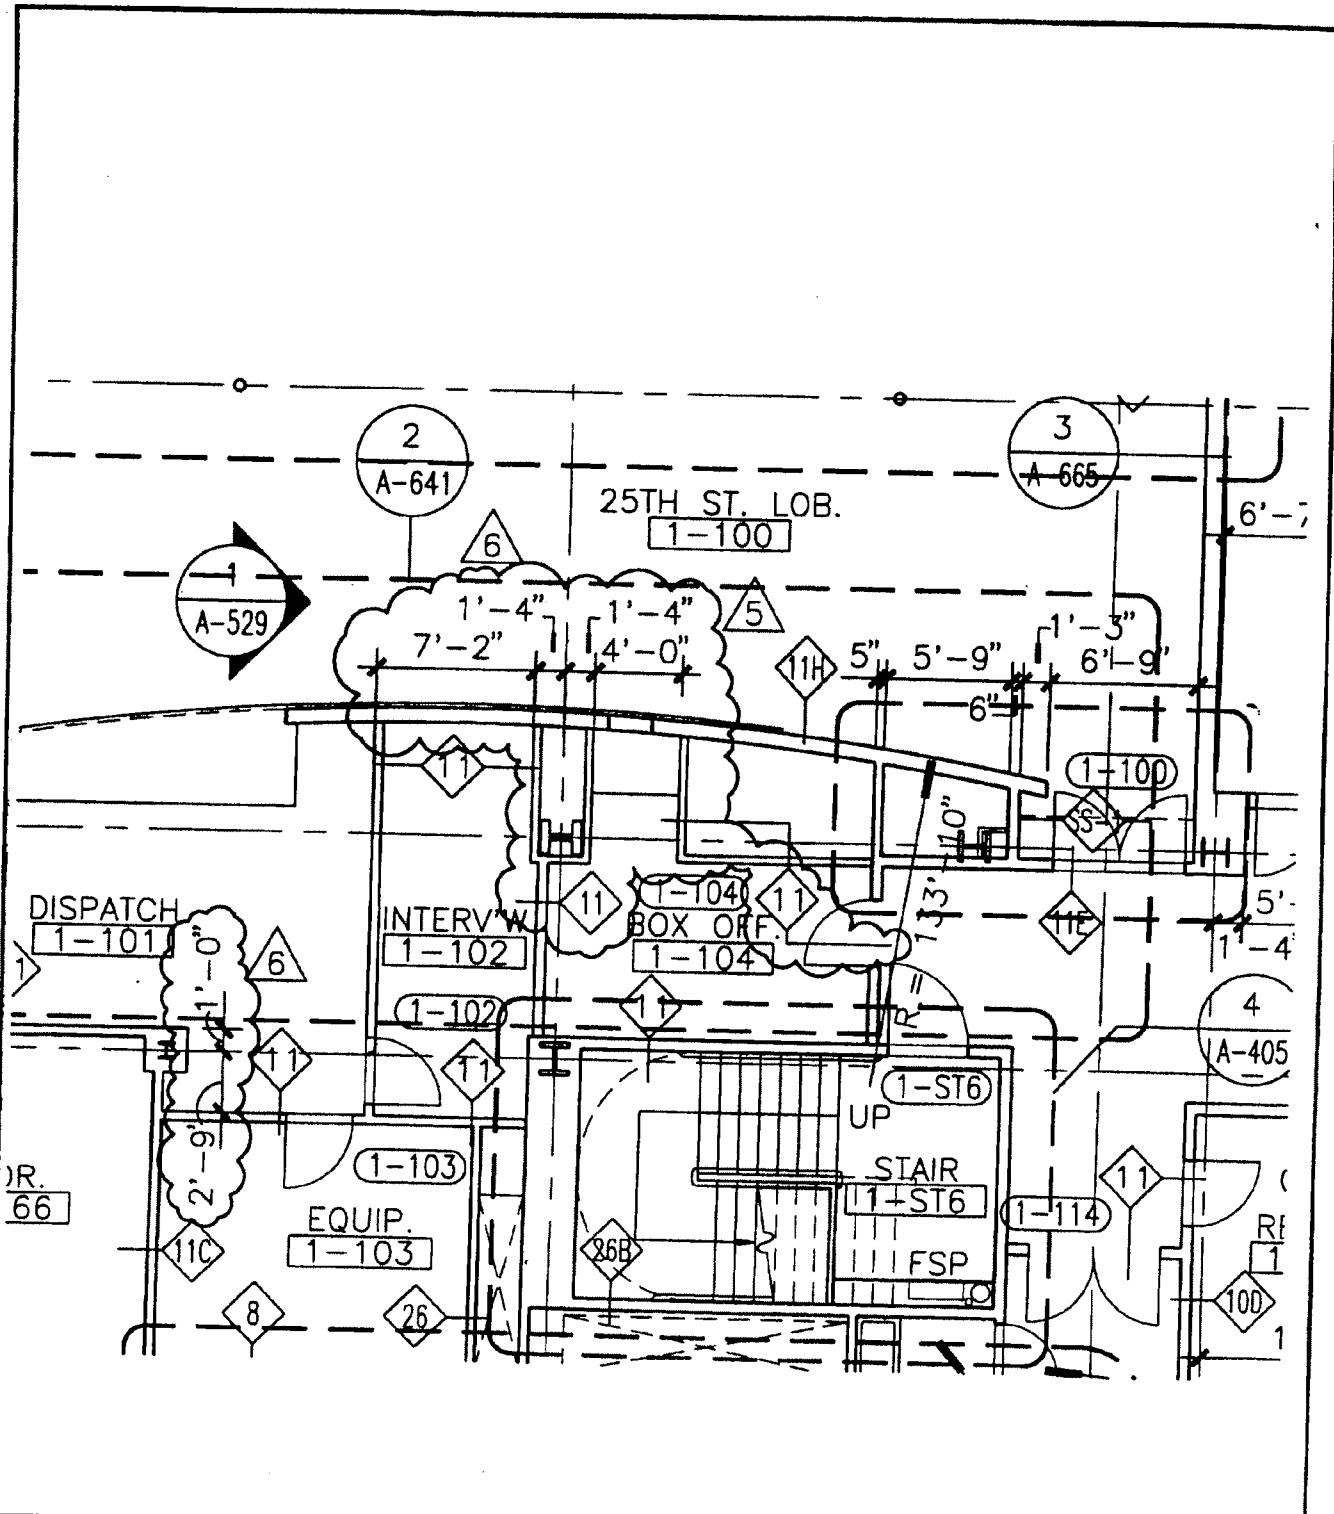

Baruch Academic Complex - Site B

55 LEXINGTON AVENUE

NEW YORK, NY 10010

ARCHITECT

KPF ASSOCIATES
111 WEST 57TH STREET
NEW YORK, NY 10019

OWNER
DORMITORY AUTHORITY OF THE STATE OF NEW YORK, DA# 6500 1802 2176
1 PENNSYLVANIA PLAZA
NEW YORK, NY 10119

REF. DETAIL/SHEET NO.

A-104

SKETCH NO.


828

NO. REVISION DATE

SCALE

1/0'-1'-0"

ADDENDUM (CONTRACT #15)

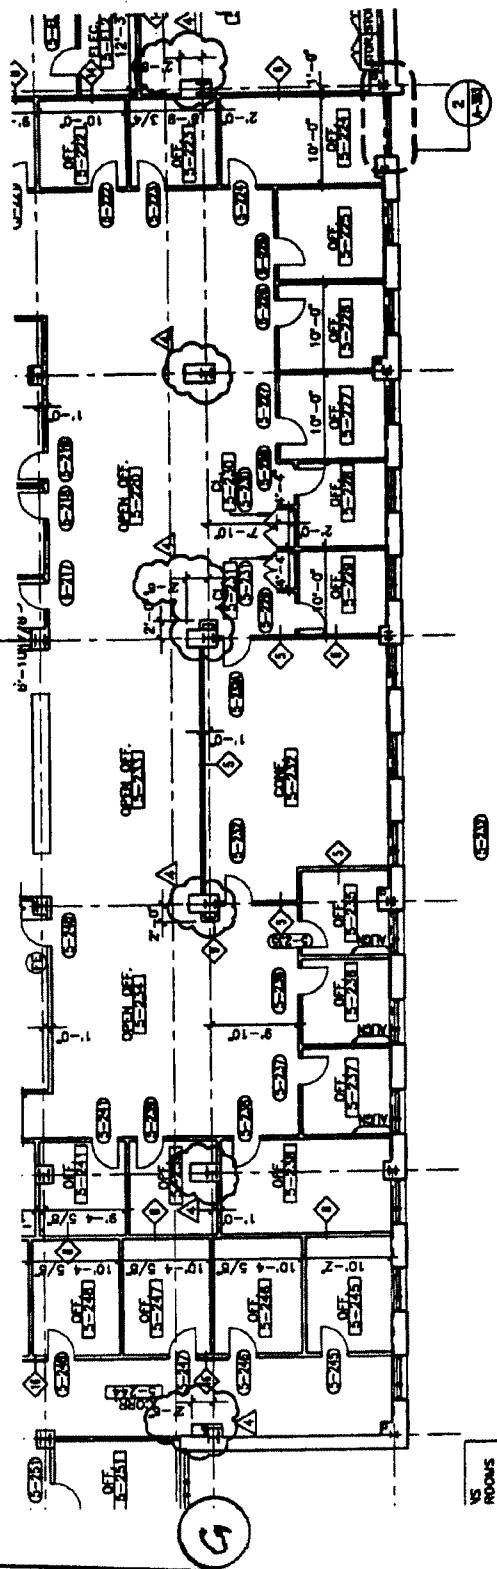

Baruch Academic Complex - Site B

55 LEXINGTON AVENUE NEW YORK, NY 10010

OWNER

DORMITORY AUTHORITY OF THE STATE OF NEW YORK, DA# 6500 1802 2176
1 PENNSYLVANIA PLAZA NEW YORK, NY 10119

NO.

REVISION

DATE

ADDENDUM #2 (CONTRACT #15)

3/3/98

ARCHITECT
KPF ASSOCIATES


111 WEST 57TH STREET
NEW YORK, NY 10019

REF. DETAIL/SHEET NO.


A-109

SKETCH NO.

829
N.T.S.

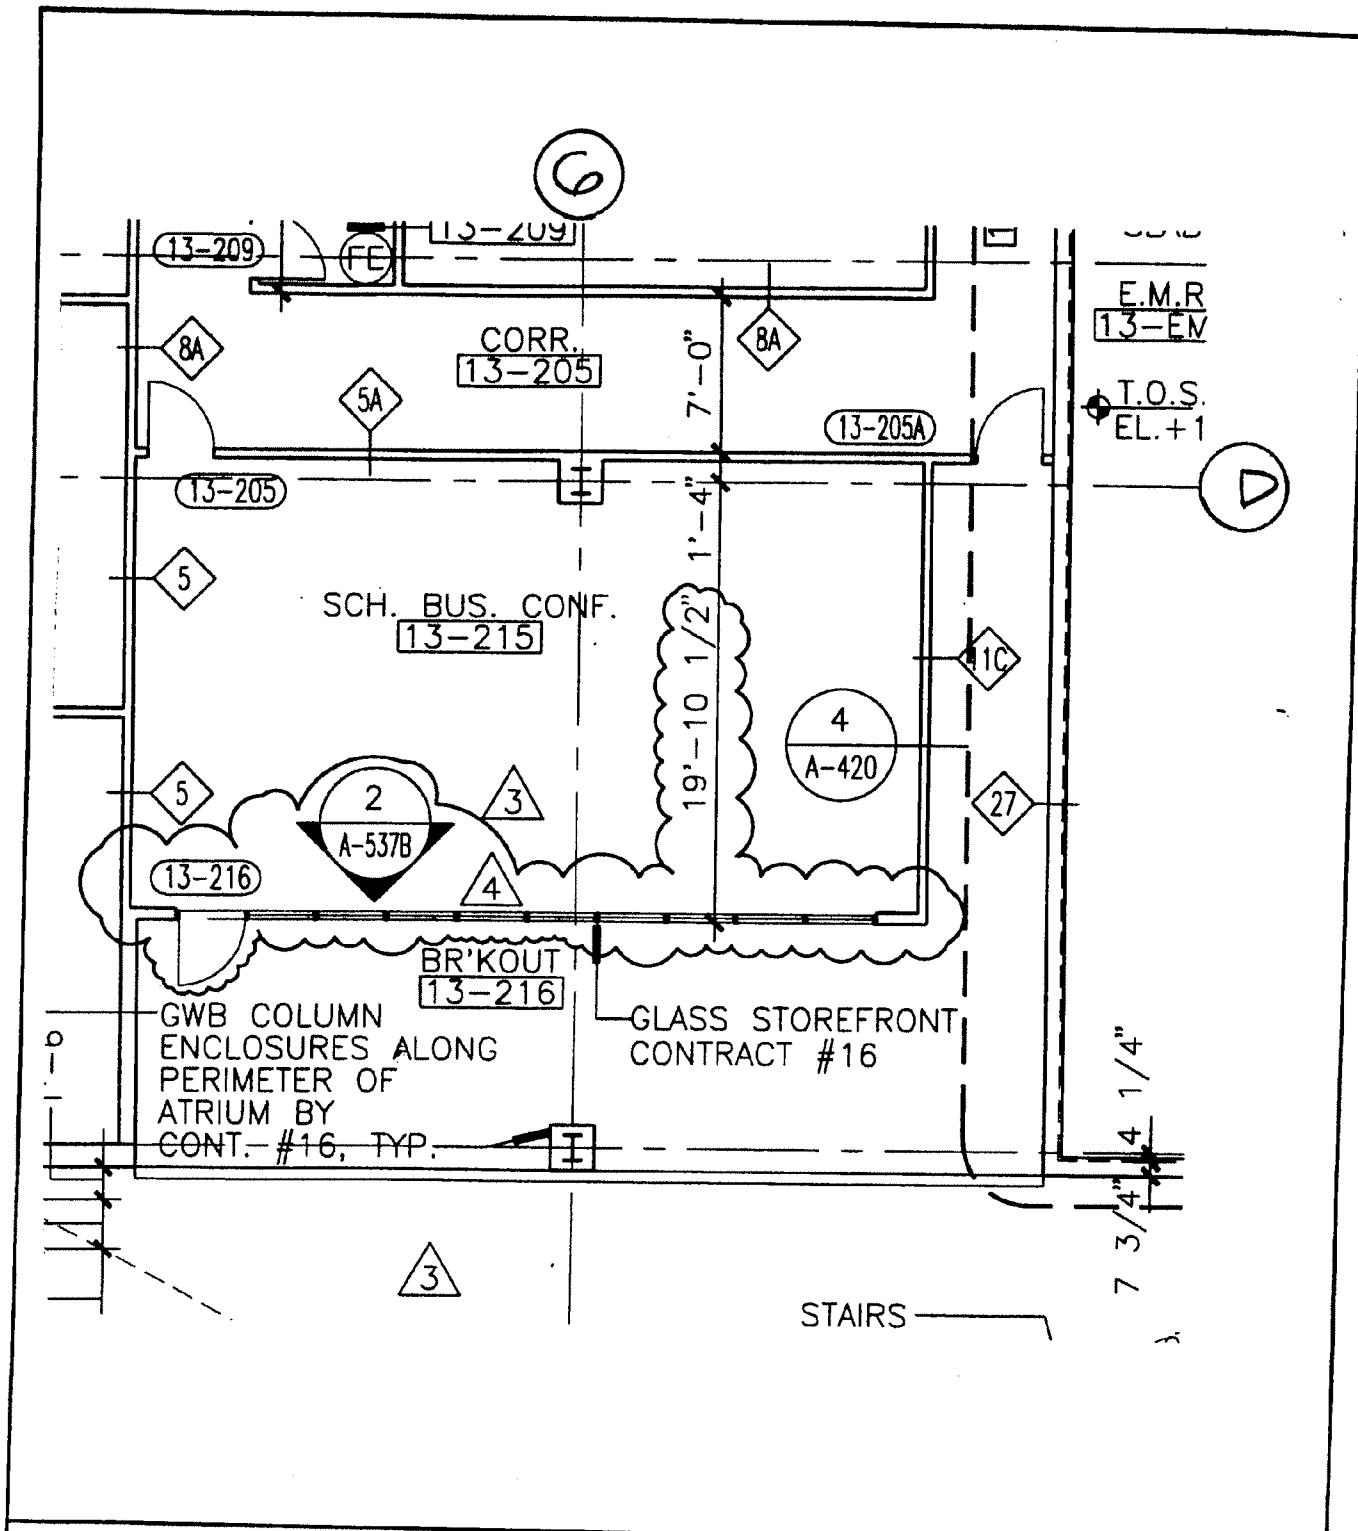

Baruch Academic Complex - Site B		ARCHITECT	
55 LEXINGTON AVENUE	NEW YORK, NY 10010	KPF ASSOCIATES	
OWNER		111 WEST 57TH STREET	
DORMITORY AUTHORITY OF THE STATE OF NEW YORK, DA# 6500 1802 2176		NEW YORK, NY 10019	
1 PENNSYLVANIA PLAZA		REF. DETAIL/SHEET NO.	
NEW YORK, NY 10119		A-117	
NO.	REVISION	DATE	SKETCH NO.
ADDENDUM • (CONTRACT #15)			SCALE 1/8" = 1'-0"
			830

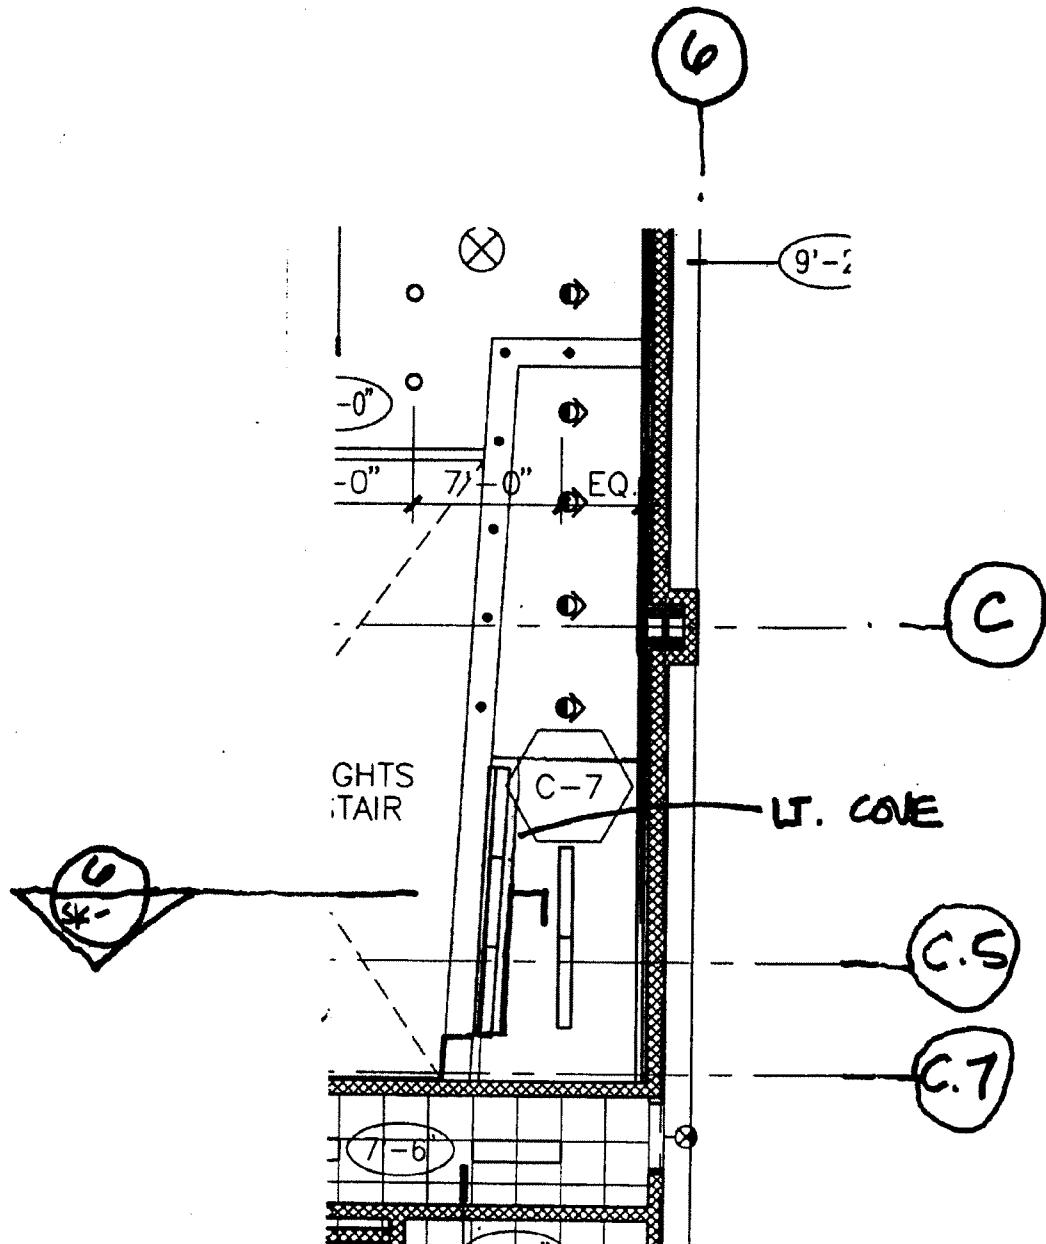

Baruch Academic Complex - Site B


55 LEXINGTON AVENUE NEW YORK, NY 10010

OWNER
DORMITORY AUTHORITY OF THE STATE OF NEW YORK, DA# 6500 1802 2176
1 PENNSYLVANIA PLAZA NEW YORK, NY 10119

ARCHITECT
KPF ASSOCIATES
111 WEST 57TH STREET
NEW YORK, NY 10019

REF. DETAIL/SHEET NO.	SKETCH NO.
A-121	831
SCALE	1'-0"

NO.	REVISION	DATE
	ADDENDUM #2 (CONTRACT #15)	3/3/98

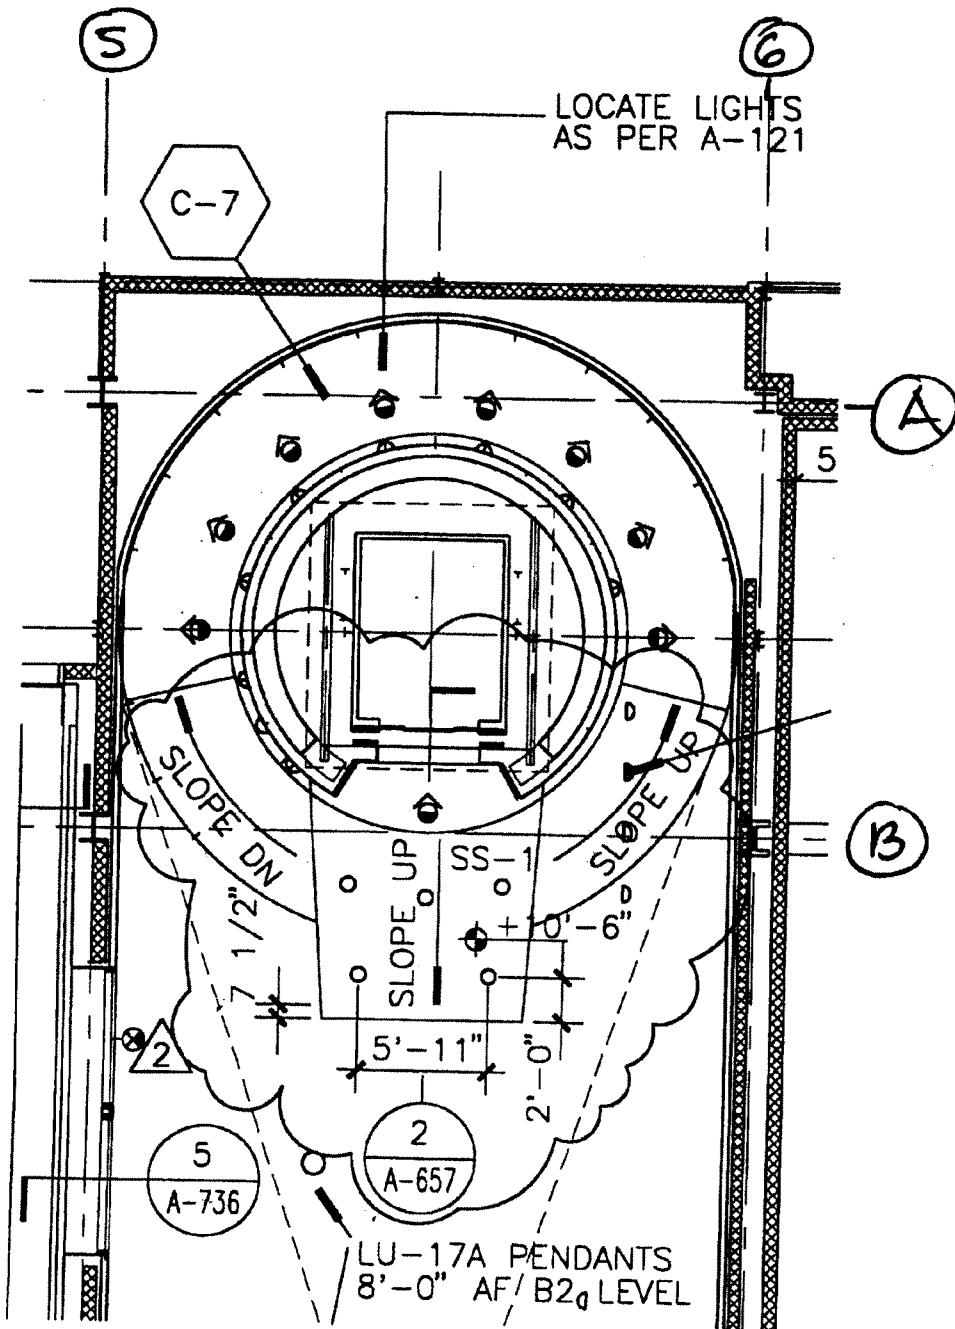

PARTIAL REF. CLR. PLAN - B2

Baruch Academic Complex - Site B

55 LEXINGTON AVENUE


NEW YORK, NY 10010

OWNER

DORMITORY AUTHORITY OF THE STATE OF NEW YORK, DA# 6500 1802 2176
1 PENNSYLVANIA PLAZA NEW YORK, NY 10119


ARCHITECT
KPF ASSOCIATES
111 WEST 57TH STREET
NEW YORK, NY 10019

NO.	REVISION	DATE	REF. DETAIL/SHEET NO.	SKETCH NO.
	ADDENDUM #2 (CONTRACT #15)	3/3/98	A-122	832

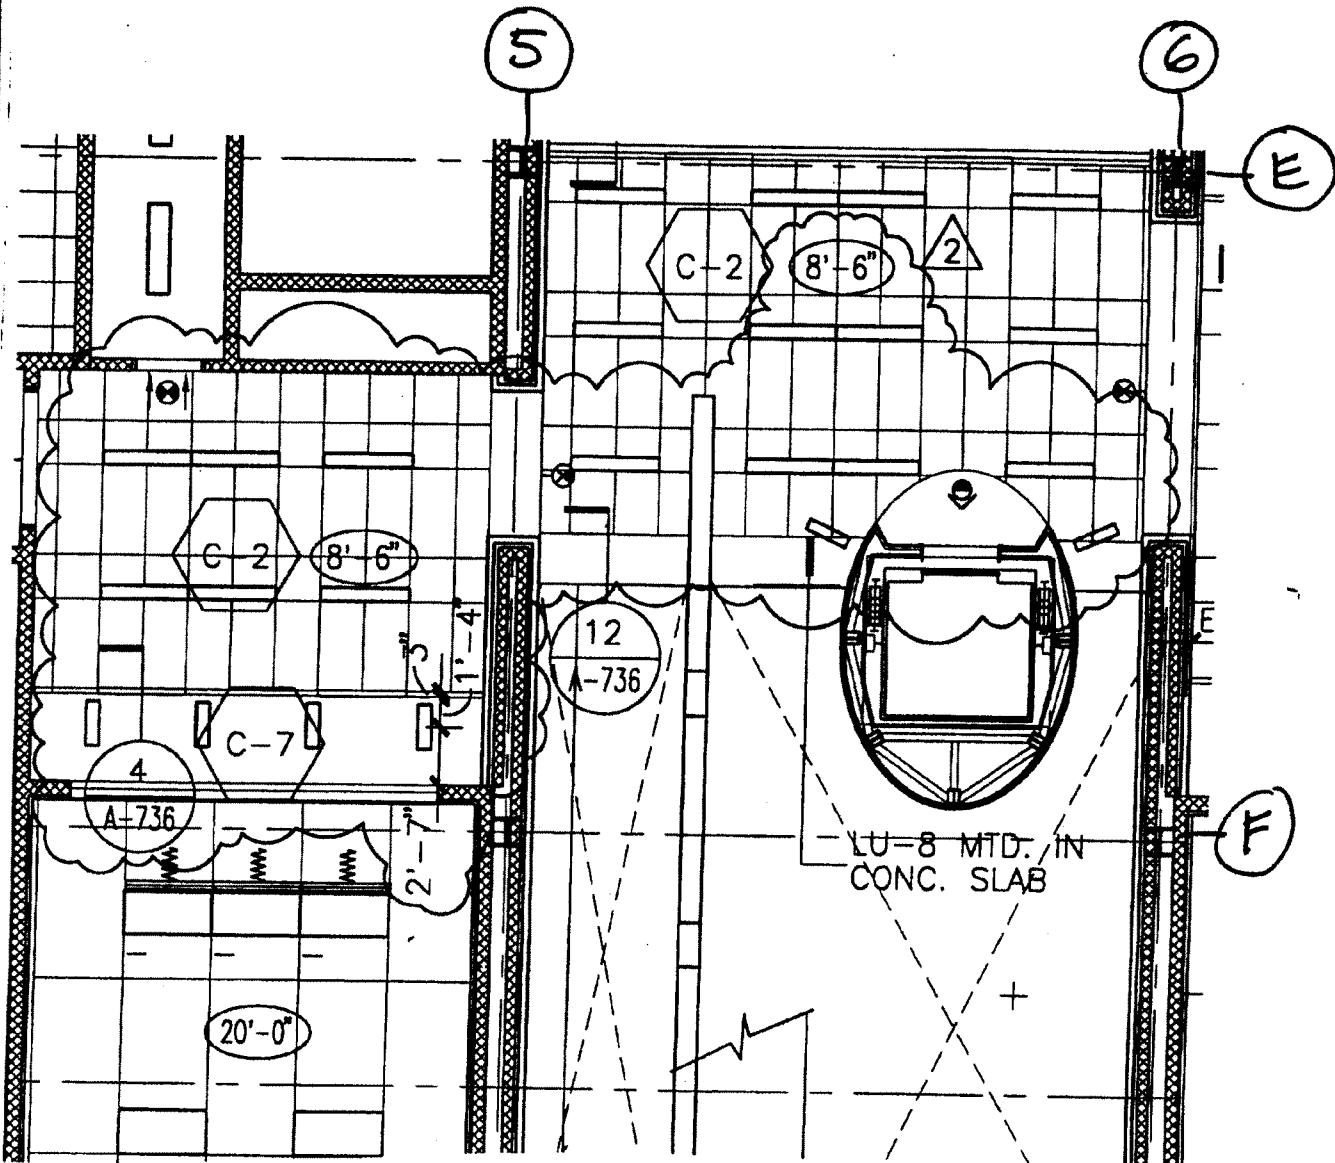


PARTIAL REFLECTED CEIL. PLAN - B2

Baruch Academic Complex - Site B			ARCHITECT KPF ASSOCIATES 111 WEST 57TH STREET NEW YORK, NY 10019
55 LEXINGTON AVENUE OWNER DORMITORY AUTHORITY OF THE STATE OF NEW YORK, DA# 6500 1802 2176 1 PENNSYLVANIA PLAZA			REF. DETAIL/SHEET NO. A-122
NO.	REVISION	DATE	SKETCH NO. 833
		3/3/98	SCALE $\frac{1}{8}'' = 1'-0''$
ADDENDUM #2 (CONTRACT #15)			

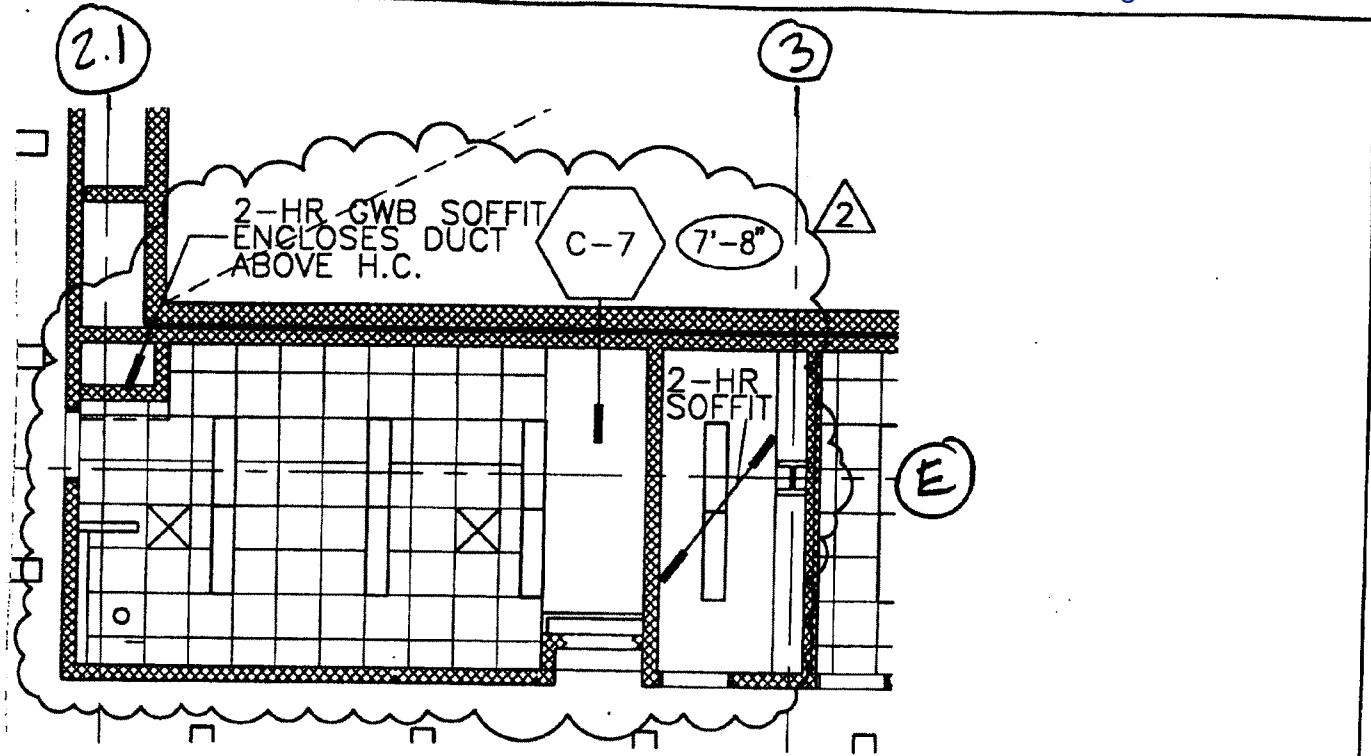

PARTIAL REF. C.G. PLAN
B2

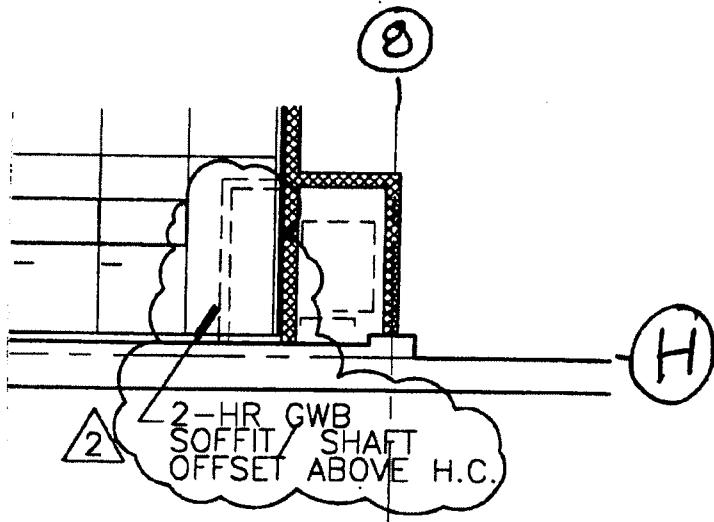

PARTIAL REF. C.G. PLAN
B2

Baruch Academic Complex - Site B

55 LEXINGTON AVENUE

NEW YORK, NY 10010

ARCHITECT

KPF ASSOCIATES
111 WEST 57TH STREET
NEW YORK, NY 10019

OWNER

DORMITORY AUTHORITY OF THE STATE OF NEW YORK, DA# 6500 1802 2176
1 PENNSYLVANIA PLAZA NEW YORK, NY 10119

NO.

REVISION

DATE

REF. DETAIL/SHEET NO.

A-122


SKETCH NO.

834

SCALE
 $1/8'' = 1'-0''$


ADDENDUM #2 (CONTRACT #15)

3/3/98

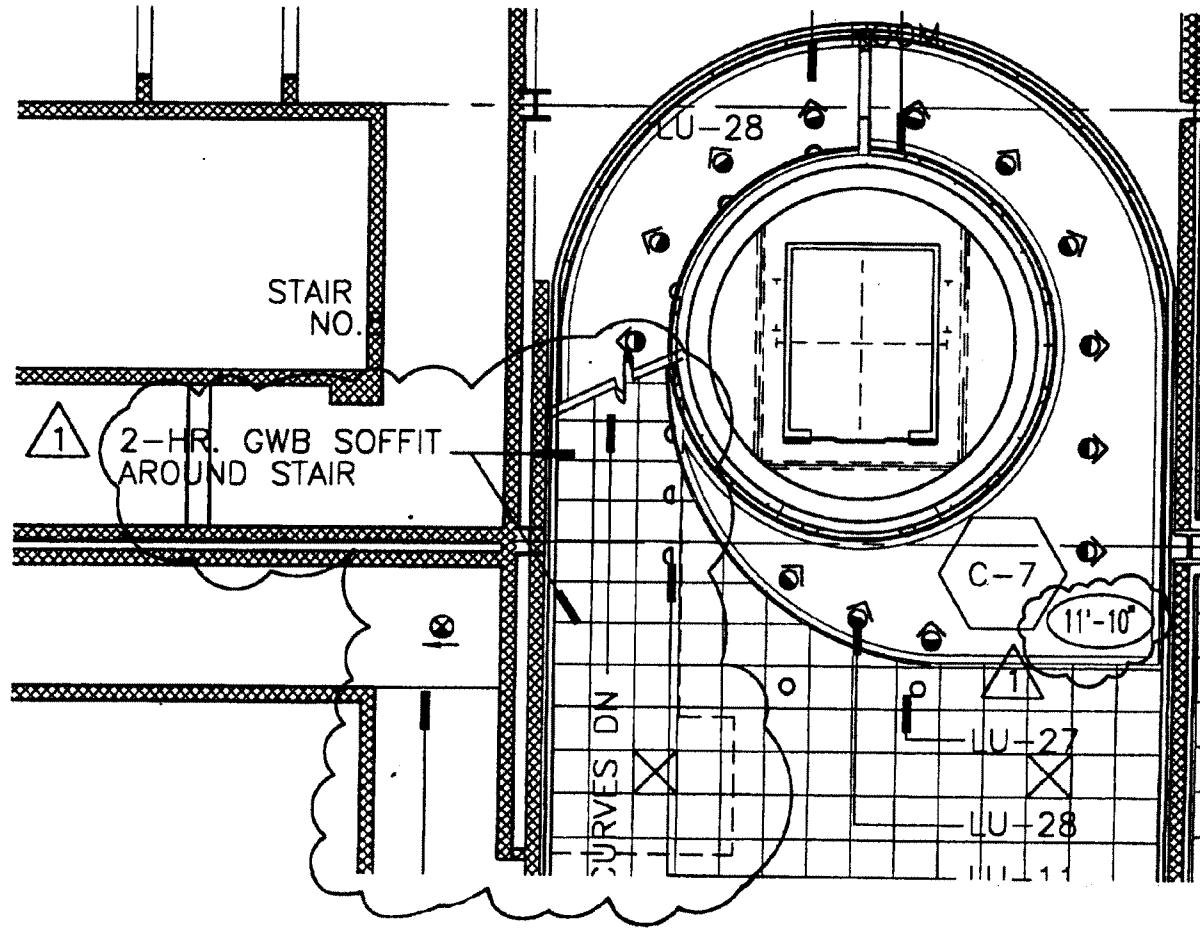

Part. REFLECTED Color Plan - B1

Baruch Academic Complex - Site B			ARCHITECT KPF ASSOCIATES 111 WEST 57TH STREET NEW YORK, NY 10019
55 LEXINGTON AVENUE	NEW YORK, NY 10010		
OWNER DORMITORY AUTHORITY OF THE STATE OF NEW YORK, DA# 6500 1802 2176 1 PENNSYLVANIA PLAZA NEW YORK, NY 10119			
NO.	REVISION	DATE	REF. DETAIL/SHEET NO. <i>A-123</i>
ADDENDUM #2 (CONTRACT #15) 3/3/98			SKETCH NO. <i>835</i>

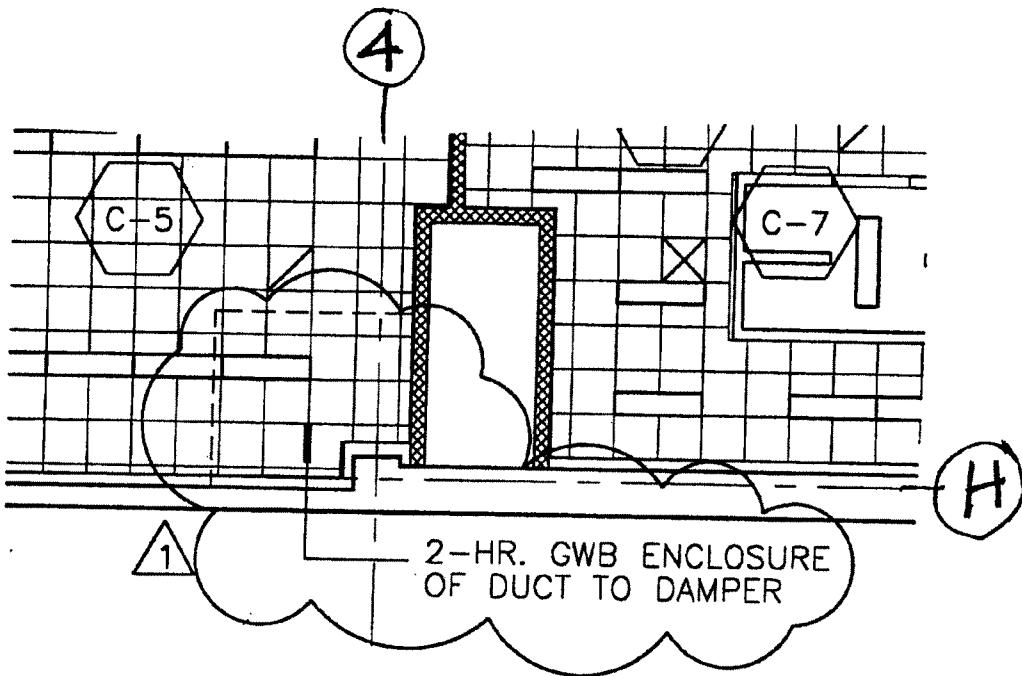

Partial Ref. Ctr. Plan - B1

Baruch Academic Complex - Site B

55 Lexington Avenue

NEW YORK, NY 10010

ARCHITECT

KPF ASSOCIATES
111 WEST 57TH STREET
NEW YORK, NY 10019

OWNER

DORMITORY AUTHORITY OF THE STATE OF NEW YORK, DA# 6500 1802 2176
1 PENNSYLVANIA PLAZA NEW YORK, NY 10119

NO.

REVISION

DATE

REF. DETAIL/SHEET NO.
A-123


SKETCH NO.

ADDENDUM #2 (CONTRACT #15)

3/3/98

SCALE 1/8"=1'-0"

836

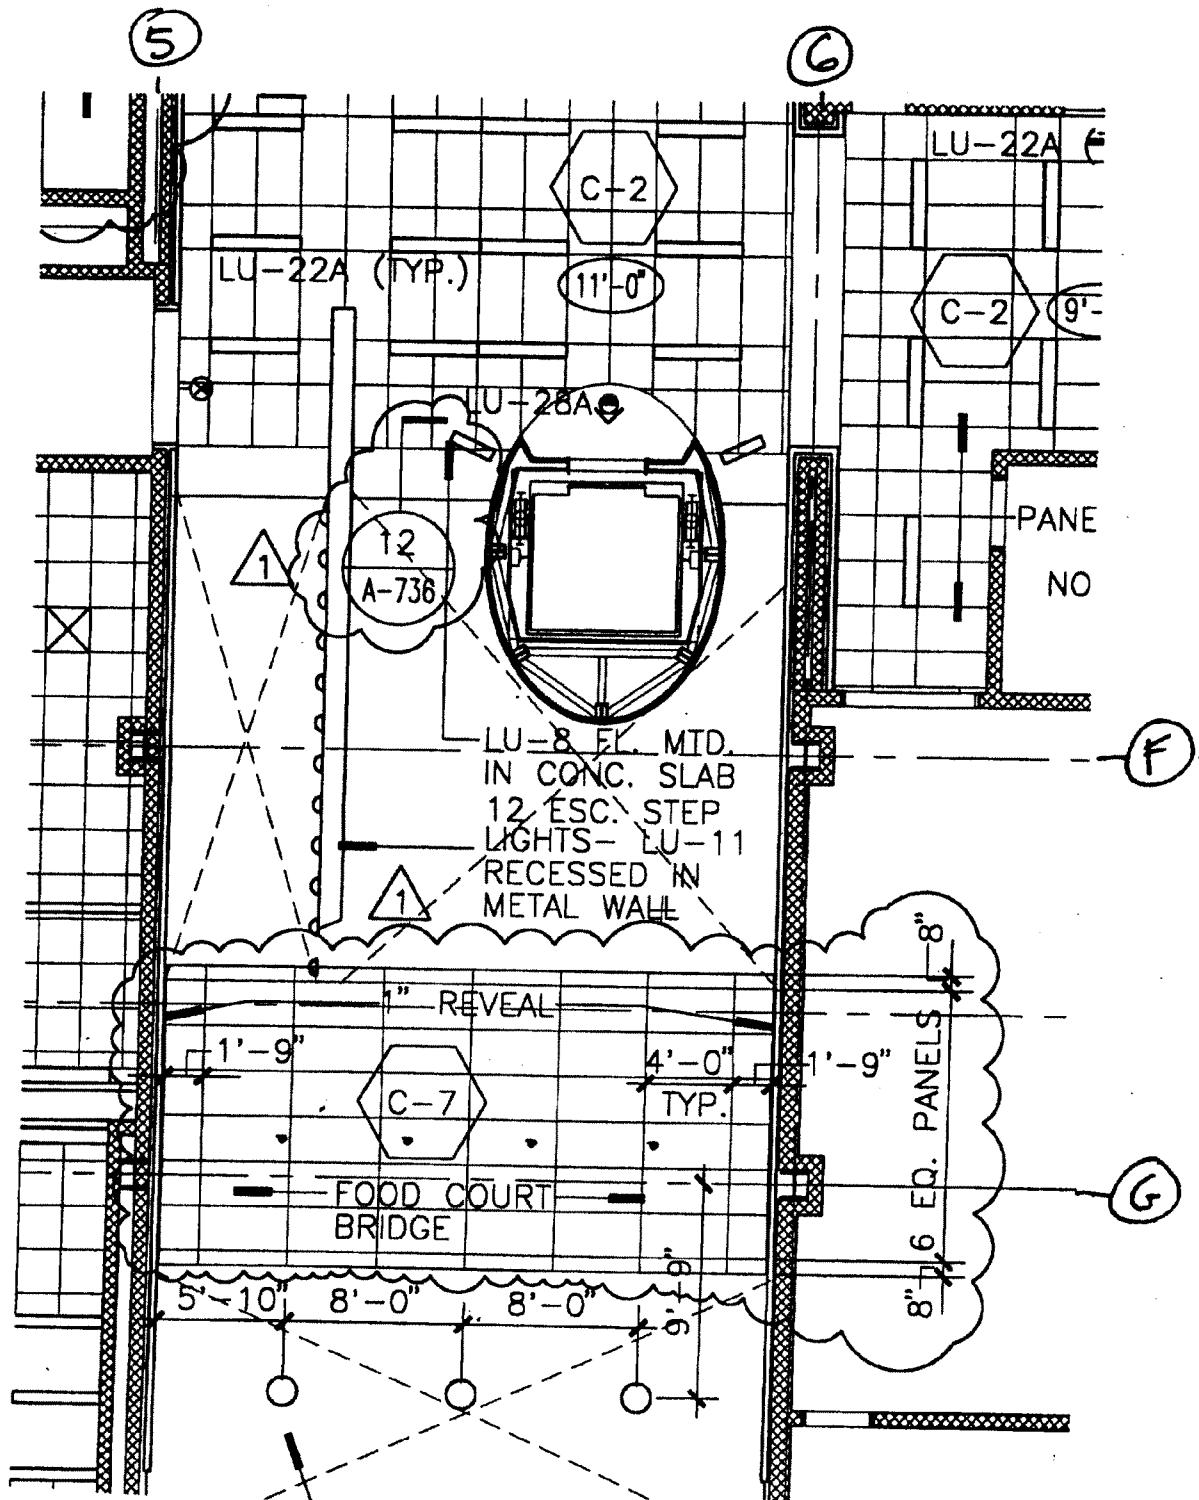

Baruch Academic Complex - Site B

55 LEXINGTON AVENUE NEW YORK, NY 10010

ARCHITECT
KPF ASSOCIATES
111 WEST 57TH STREET
NEW YORK, NY 10019

OWNER
DORMITORY AUTHORITY OF THE STATE OF NEW YORK, DA# 6500 1802 2176
1 PENNSYLVANIA PLAZA NEW YORK, NY 10119


REF. DETAIL/SHEET NO.

A-123

SKETCH NO.


837

NO.	REVISION	DATE
	ADDENDUM #2 (CONTRACT #15)	3/3/98

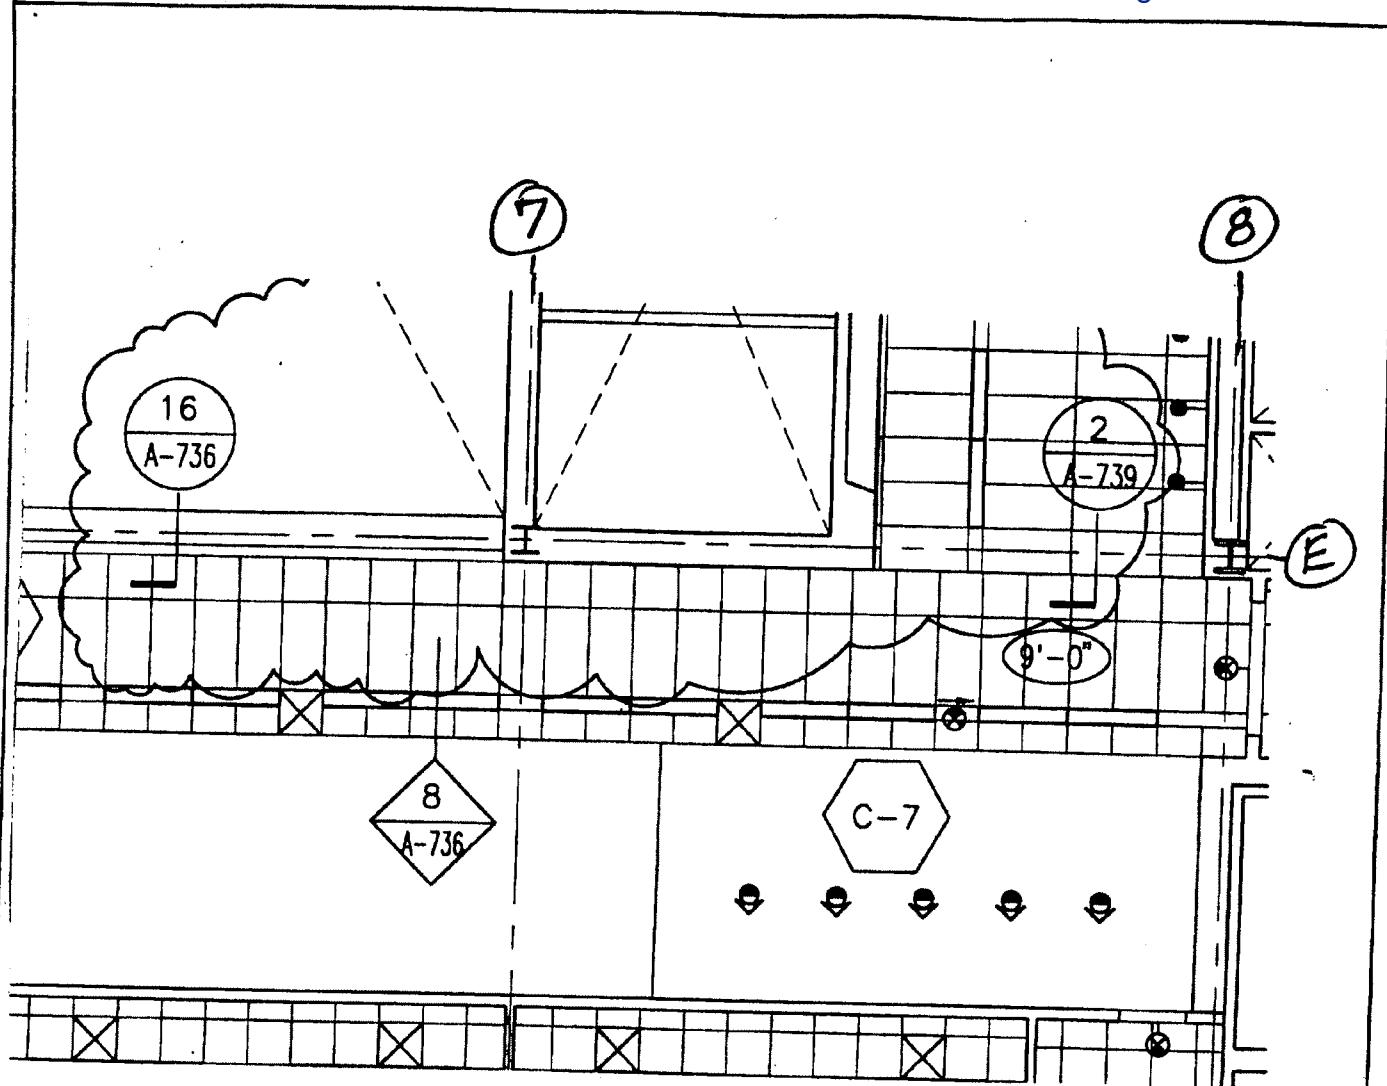


PARTIAL REFLECTED LINE. PIANO - 3RD FL.
 (NOTE: DETAIL 2/A-739 APPLIES AT SAME
 LOCATION FLOORS 4 & 5)

Baruch Academic Complex - Site B			ARCHITECT KPF ASSOCIATES 111 WEST 57TH STREET NEW YORK, NY 10019
55 LEXINGTON AVENUE NEW YORK, NY 10010			
OWNER DORMITORY AUTHORITY OF THE STATE OF NEW YORK, DA# 6500 1802 2176 1 PENNSYLVANIA PLAZA NEW YORK, NY 10119			REF. DETAIL/SHEET NO. <i>A-126</i>
NO.	REVISION	DATE	SKETCH NO. <i>B38</i>
		3/3/98	SCALE $\frac{1}{8}'' = 1'-0''$
ADDENDUM #2 (CONTRACT #15)			

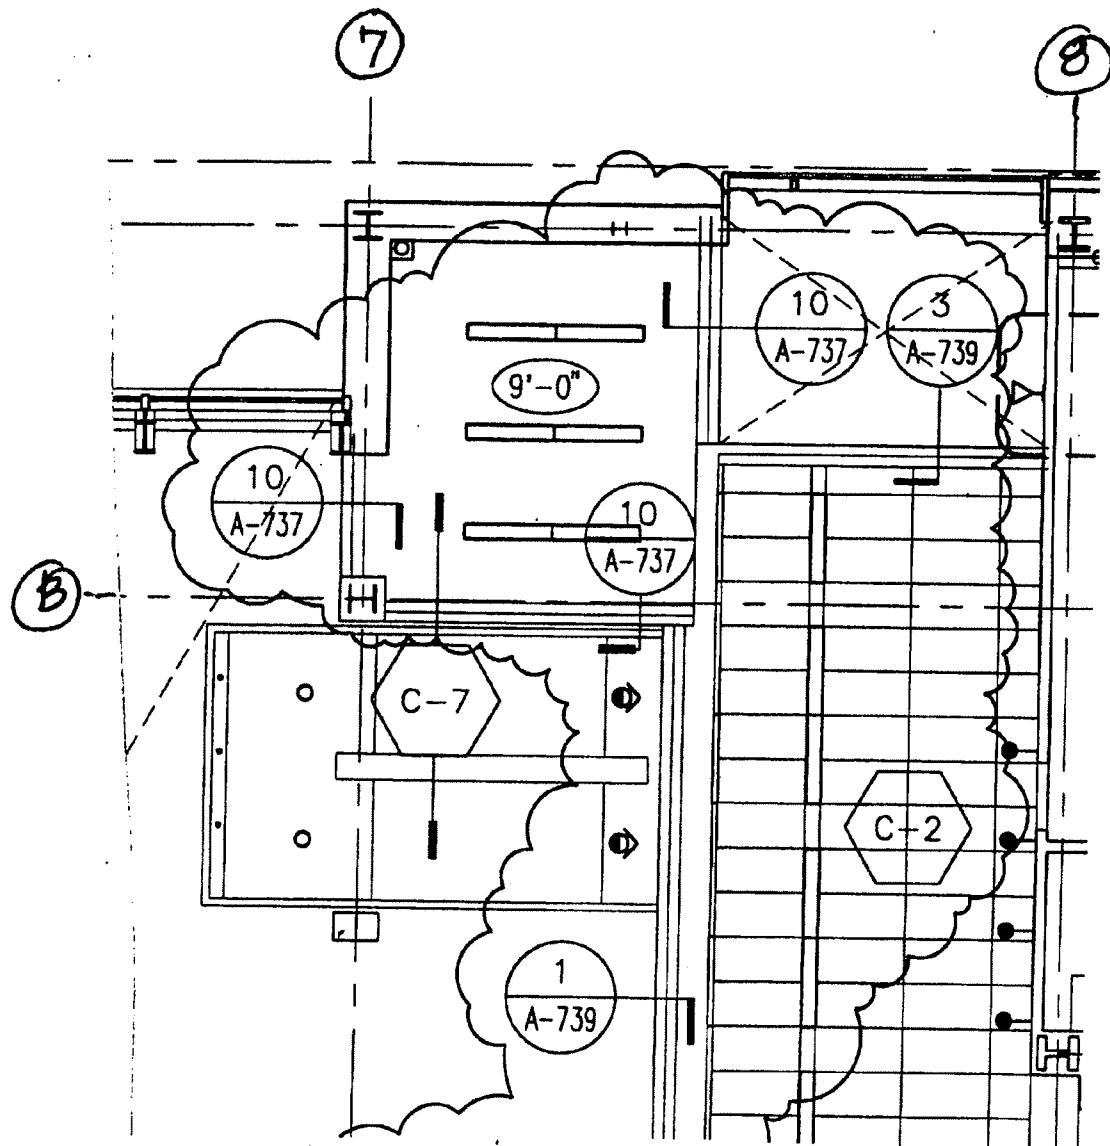


PARTIAL REFLECTED CEIL. PLAN
3RD FL.
(4TH - 5TH FLOORS SIMILAR)

Baruch Academic Complex - Site B			ARCHITECT
55 LEXINGTON AVENUE	NEW YORK, NY 10010	KPF ASSOCIATES	111 WEST 57TH STREET
OWNER			NEW YORK, NY 10019
DORMITORY AUTHORITY OF THE STATE OF NEW YORK, DA# 6500 1802 2176		REF. DETAIL/SHEET NO.	SKETCH NO.
1 PENNSYLVANIA PLAZA	NEW YORK, NY 10119	A-126	839
NO.	REVISION	DATE	SCALE $\frac{1}{8}'' = 1'-0''$
		3/3/98	
ADDENDUM #2 (CONTRACT #15)			

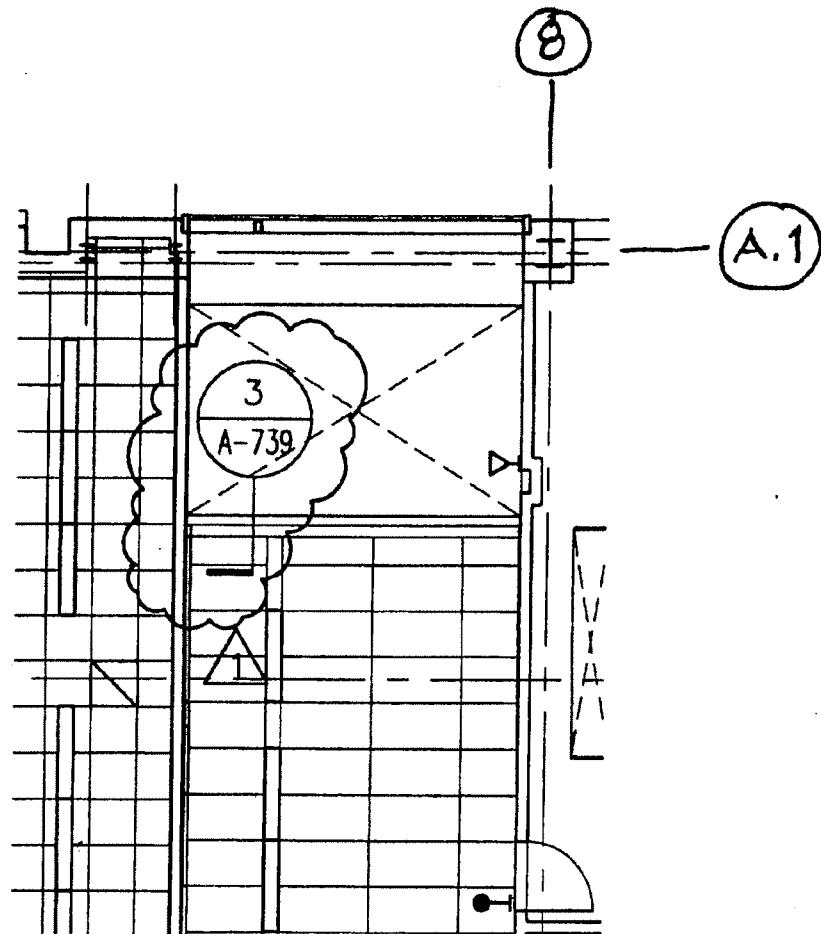

PARTIAL REFLECTED CLO. PLAN
8TH FL.
(9TH - 11TH FLOORS SIMILAR)

Baruch Academic Complex - Site B			ARCHITECT KPF ASSOCIATES 111 WEST 57TH STREET NEW YORK, NY 10019
55 LEXINGTON AVENUE NEW YORK, NY 10010			
OWNER DORMITORY AUTHORITY OF THE STATE OF NEW YORK, DA# 6500 1802 2176 1 PENNSYLVANIA PLAZA NEW YORK, NY 10119	REF. DETAIL/SHEET NO. A-131	SKETCH NO. 840	
NO.	REVISION	DATE	SCALE —
	ADDENDUM #2 (CONTRACT #15)	3/3/98	

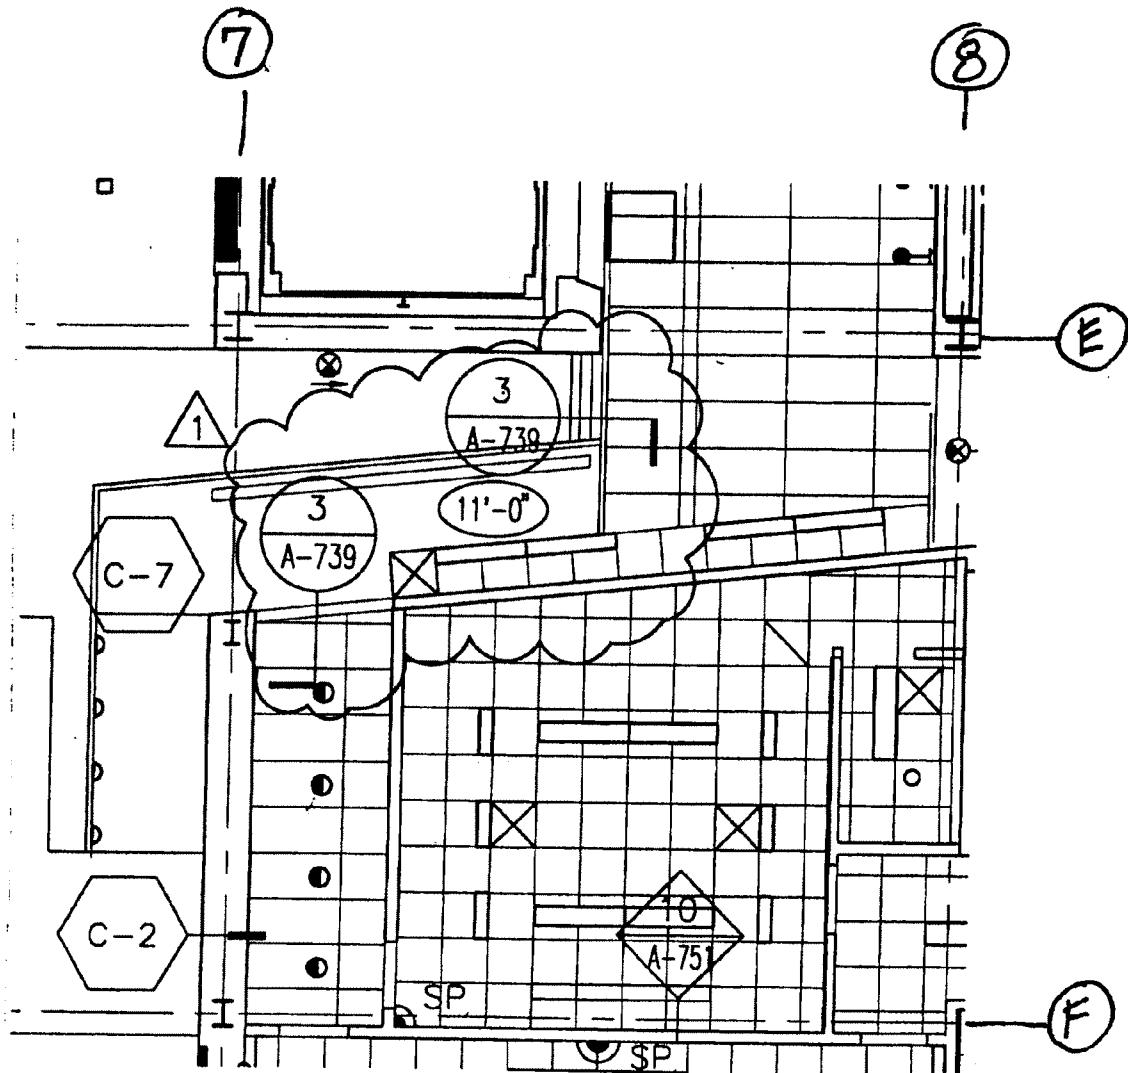**Baruch Academic Complex - Site B**

55 LEXINGTON AVENUE NEW YORK, NY 10010

ARCHITECT
KPF ASSOCIATES
111 WEST 57TH STREET
NEW YORK, NY 10019

OWNER
DORMITORY AUTHORITY OF THE STATE OF NEW YORK, DA# 6500 1802 2176
1 PENNSYLVANIA PLAZA NEW YORK, NY 10119

NO. REVISION DATE


ADDENDUM #2 (CONTRACT #15) 3/3/98

REF. DETAL/SHEET NO.

A-131

SKETCH NO.

SCALE $\frac{1}{8}'' = 1'-0''$ **841**

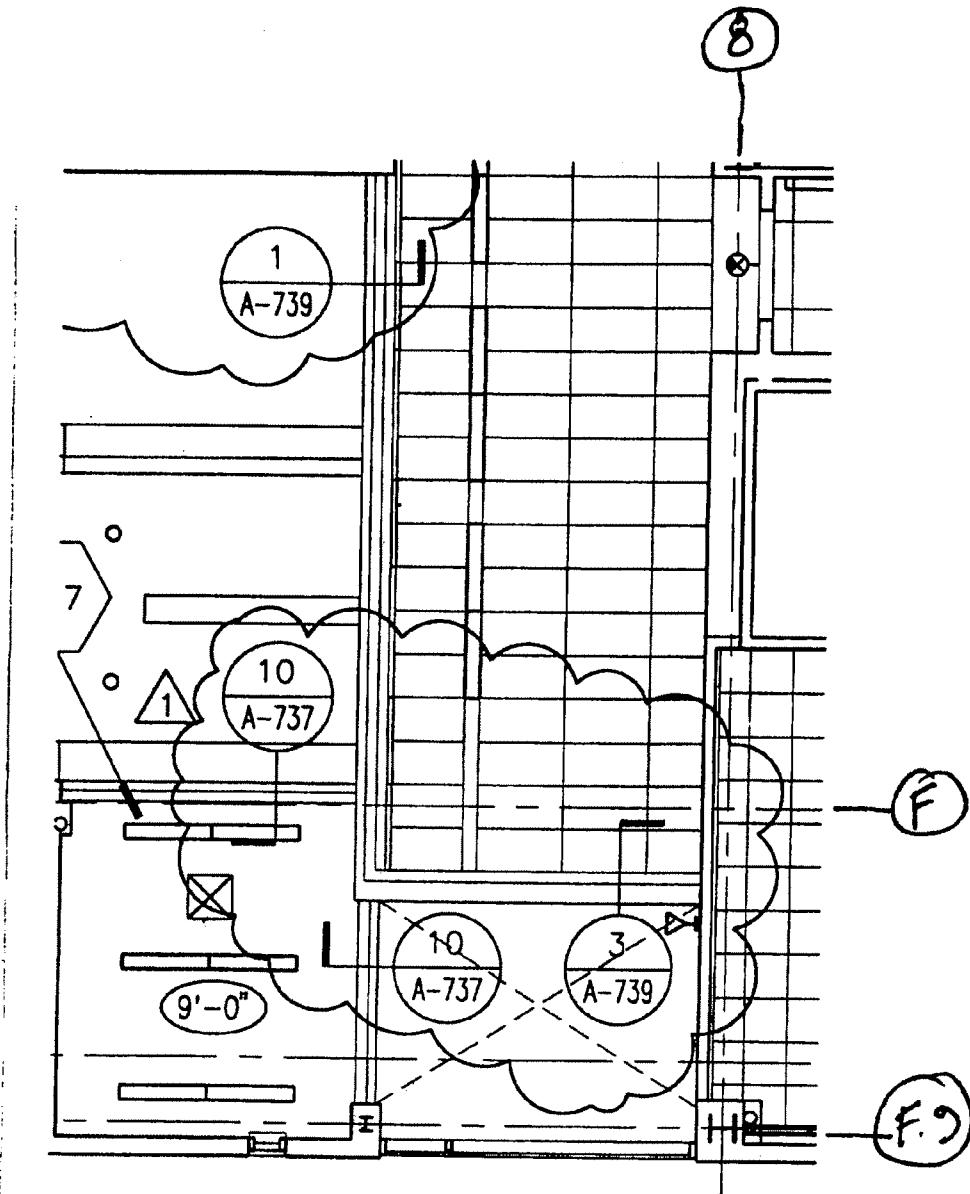

PARTIAL REFLECTED CLG. PLAN
9TH FL
(10TH - 12TH FLOORS SIMILAR)


Baruch Academic Complex - Site B

55 LEXINGTON AVENUE NEW YORK, NY 10010

OWNER
DORMITORY AUTHORITY OF THE STATE OF NEW YORK, DA# 6500 1802 2176
1 PENNSYLVANIA PLAZA NEW YORK, NY 10119

ARCHITECT
KPF ASSOCIATES
111 WEST 57TH STREET
NEW YORK, NY 10019

NO.	REVISION	DATE	REF. DETAIL/SHEET NO.	SKETCH NO.
	ADDENDUM #2 (CONTRACT #15)	3/3/98	A-132	842

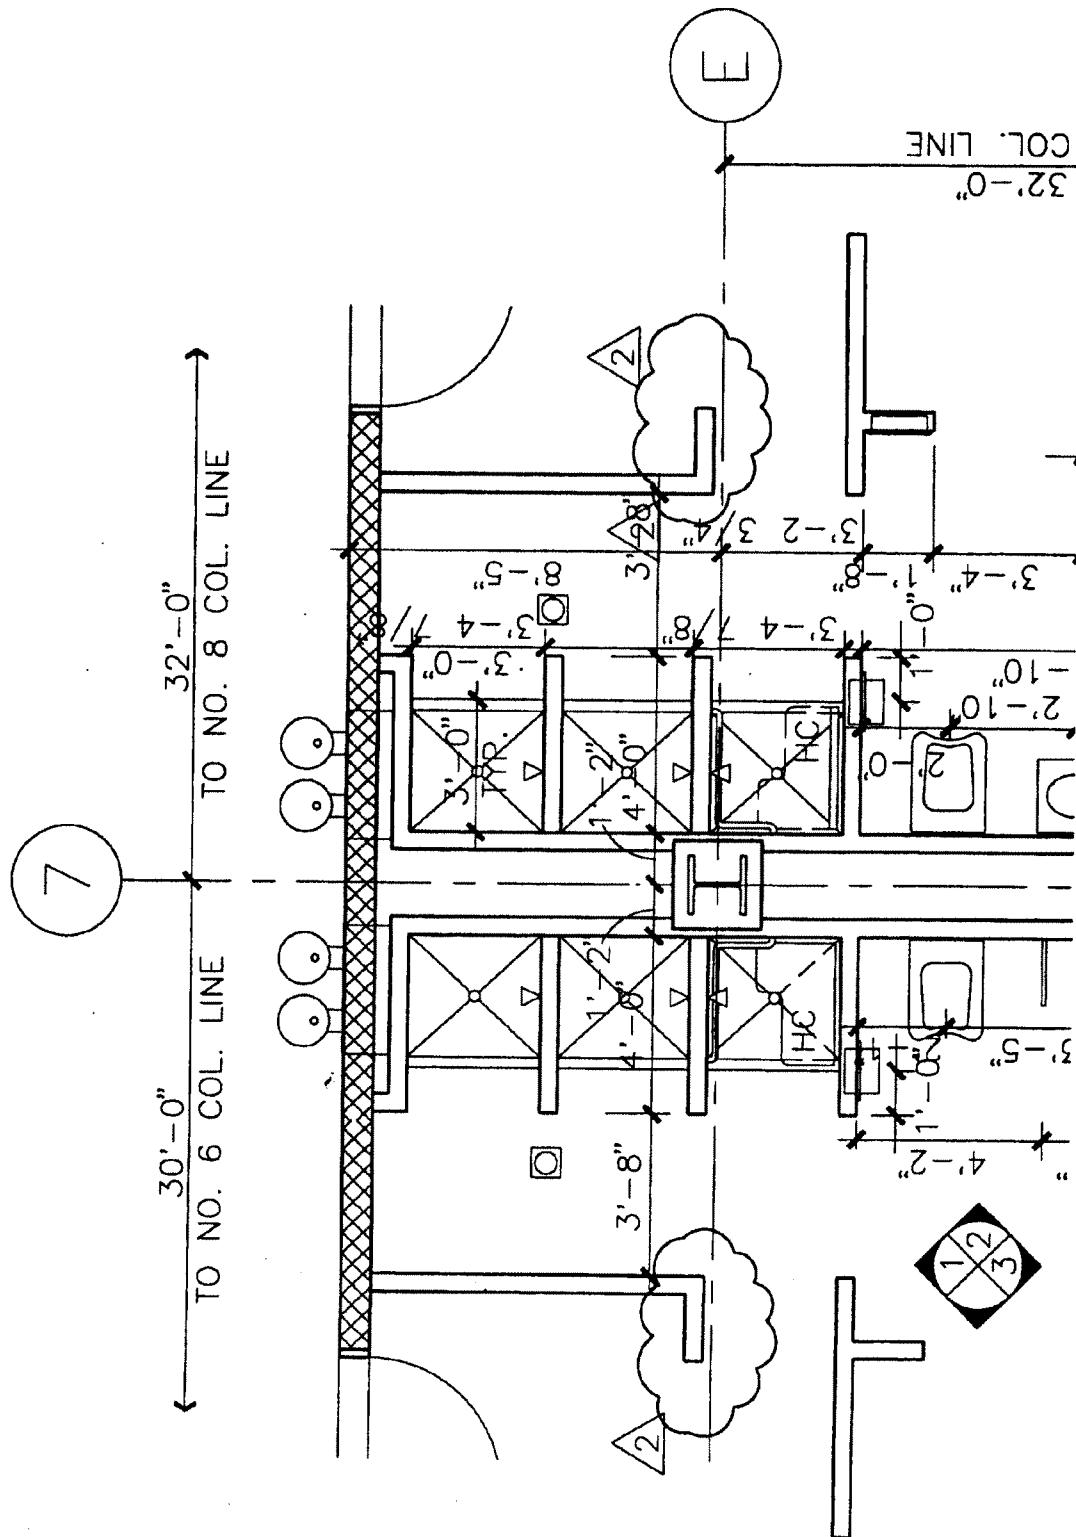**Baruch Academic Complex - Site B**

55 LEXINGTON AVENUE

NEW YORK, NY 10010

ARCHITECT

KPF ASSOCIATES
111 WEST 57TH STREET
NEW YORK, NY 10019

OWNER

DORMITORY AUTHORITY OF THE STATE OF NEW YORK, DA# 6500 1802 2176
1 PENNSYLVANIA PLAZA NEW YORK, NY 10119

NO.

REVISION

DATE

REF. DETAIL/SHEET NO.

4/A445

SKETCH NO.

ADDENDUM #2 (CONTRACT #15)


3/3/98

SCALE
 $1/4'' = 1'-0''$

813

7


32'-0"

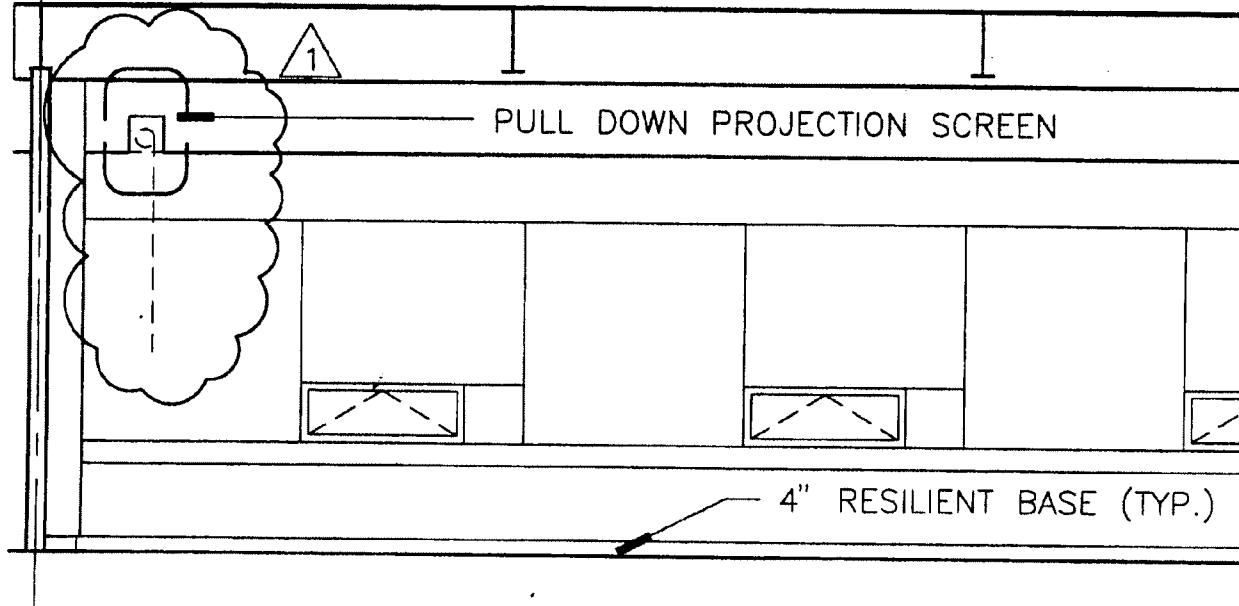**Baruch Academic Complex - Site B**

55 LEXINGTON AVENUE NEW YORK, NY 10010

OWNER
 DORMITORY AUTHORITY OF THE STATE OF NEW YORK, DA# 6500 1802 2176
 1 PENNSYLVANIA PLAZA NEW YORK, NY 10119

NO.	REVISION	DATE	ARCHITECT KPF ASSOCIATES 111 WEST 57TH STREET NEW YORK, NY 10019
	ADDENDUM #2 (CONTRACT #15)	3/3/98	REF. DETAIL/SHEET NO. 1/A - 568 SKETCH NO. SCALE 1/4"-1'-0 844

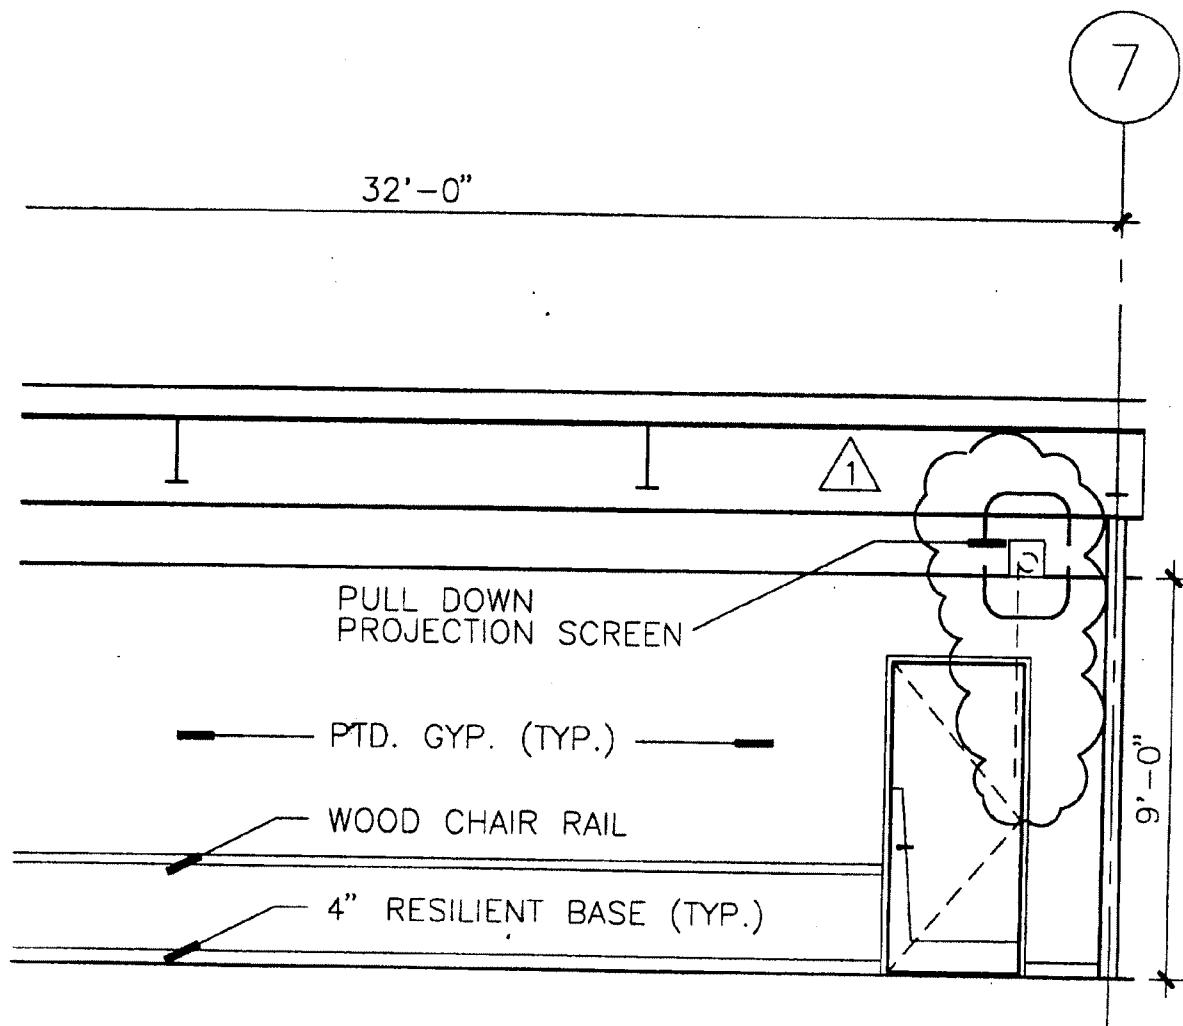

Baruch Academic Complex - Site B

55 Lexington Avenue

New York, NY 10010

OWNER

DORMITORY AUTHORITY OF THE STATE OF NEW YORK, DA# 6500 1802 2176
1 PENNSYLVANIA PLAZA

New York, NY 10119

ARCHITECT

KPF ASSOCIATES
111 WEST 57TH STREET
NEW YORK, NY 10019

REF. DETAIL/SHEET NO.

2/A-568

SKETCH NO.

845

NO.

REVISION


DATE

ADDENDUM #2 (CONTRACT #15)

3/3/98

SCALE

1/4" - 1'-0"

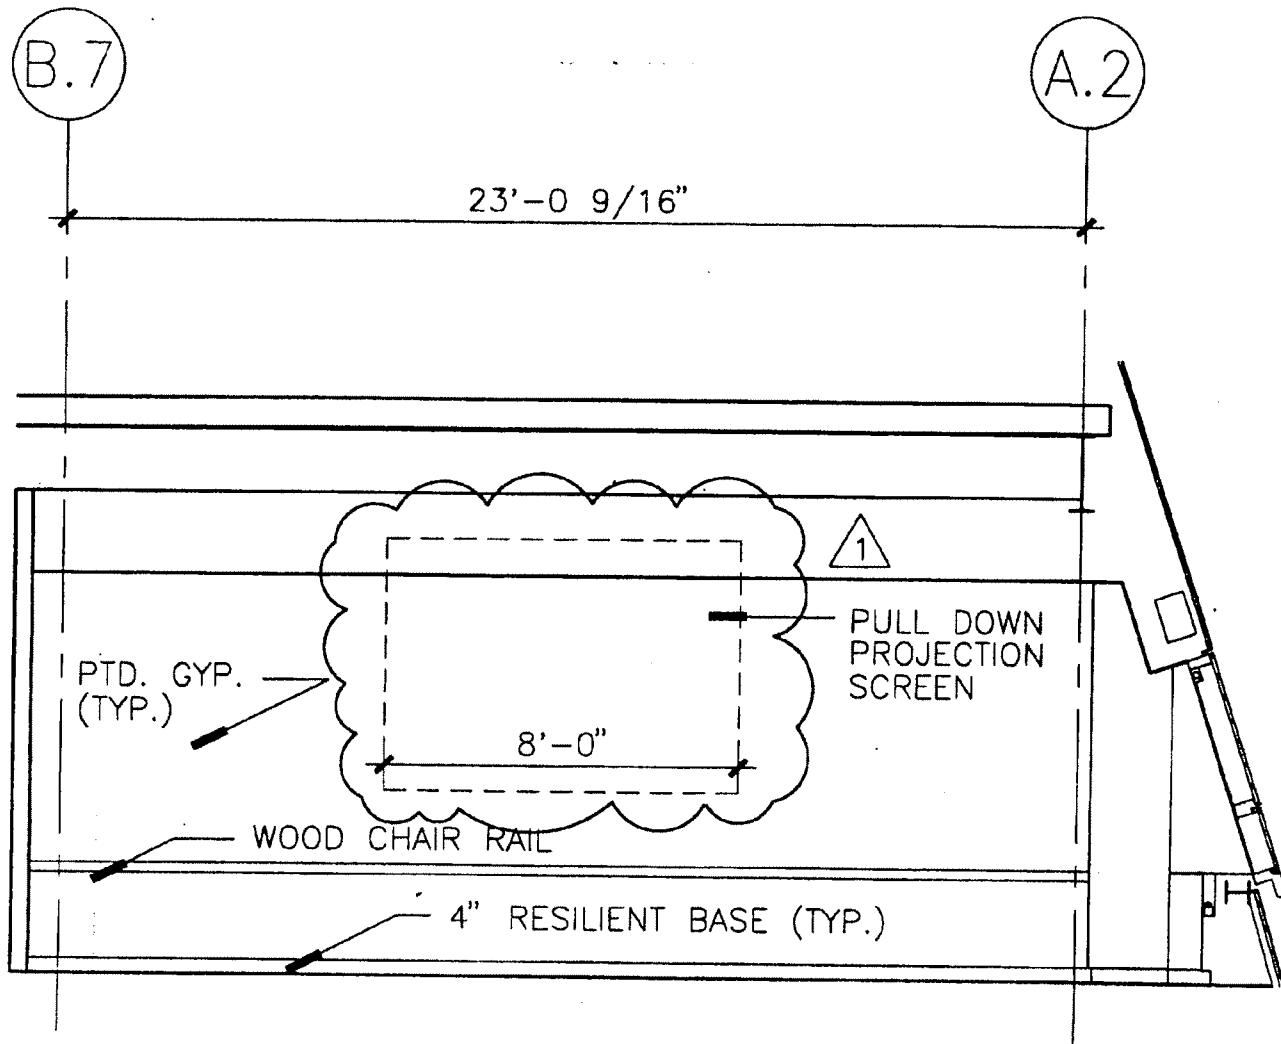

Baruch Academic Complex - Site B

55 Lexington Avenue NEW YORK, NY 10010


OWNER

DORMITORY AUTHORITY OF THE STATE OF NEW YORK, DA# 6500 1802 2176
1 PENNSYLVANIA PLAZA NEW YORK, NY 10119

NO.	REVISION	DATE
	ADDENDUM #2 (CONTRACT #15)	3/3/98

ARCHITECT
KPF ASSOCIATES
111 WEST 57TH STREET
NEW YORK, NY 10019

REF. DETAIL/SHEET NO.	SKETCH NO.
41A-568	
YA "- 1" - 0"	846

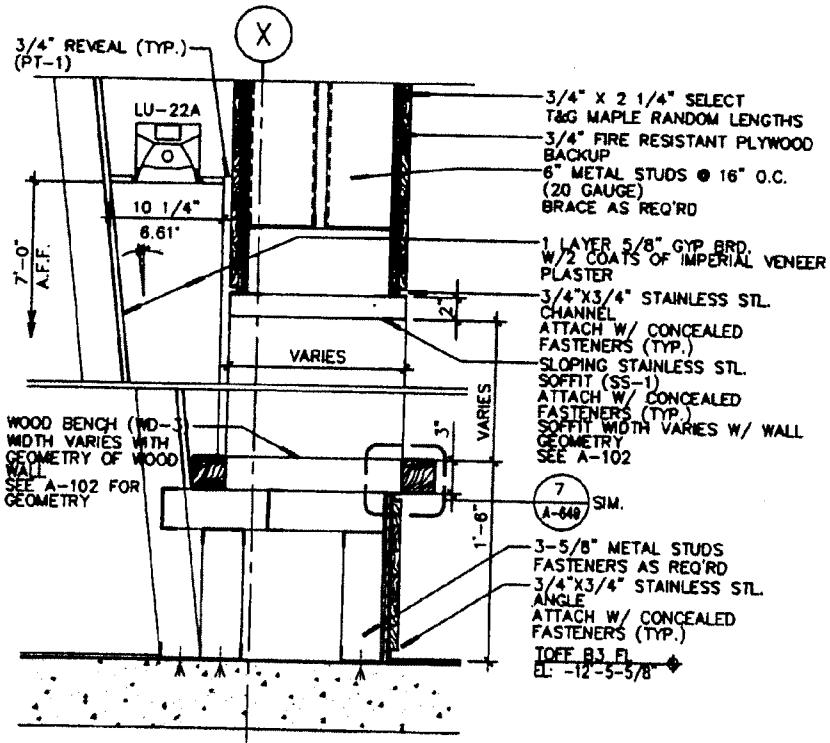

6 WOOD BENCH SECTION DETAIL

Baruch Academic Complex - Site B

55 Lexington Avenue

New York, NY 10010

OWNER

DORMITORY AUTHORITY OF THE STATE OF NEW YORK, DA# 6500 1802 2176
1 PENNSYLVANIA PLAZA NEW YORK, NY 10119

NO.

REVISION

DATE

ADDENDUM #2 (CONTRACT #15)

3/3/98

ARCHITECT

KPF ASSOCIATES
111 WEST 57TH STREET
NEW YORK, NY 10019

REF. DETAIL/SHEET NO.


A-646

SKETCH NO.


847

SCALE

3/4" - 1 - 011

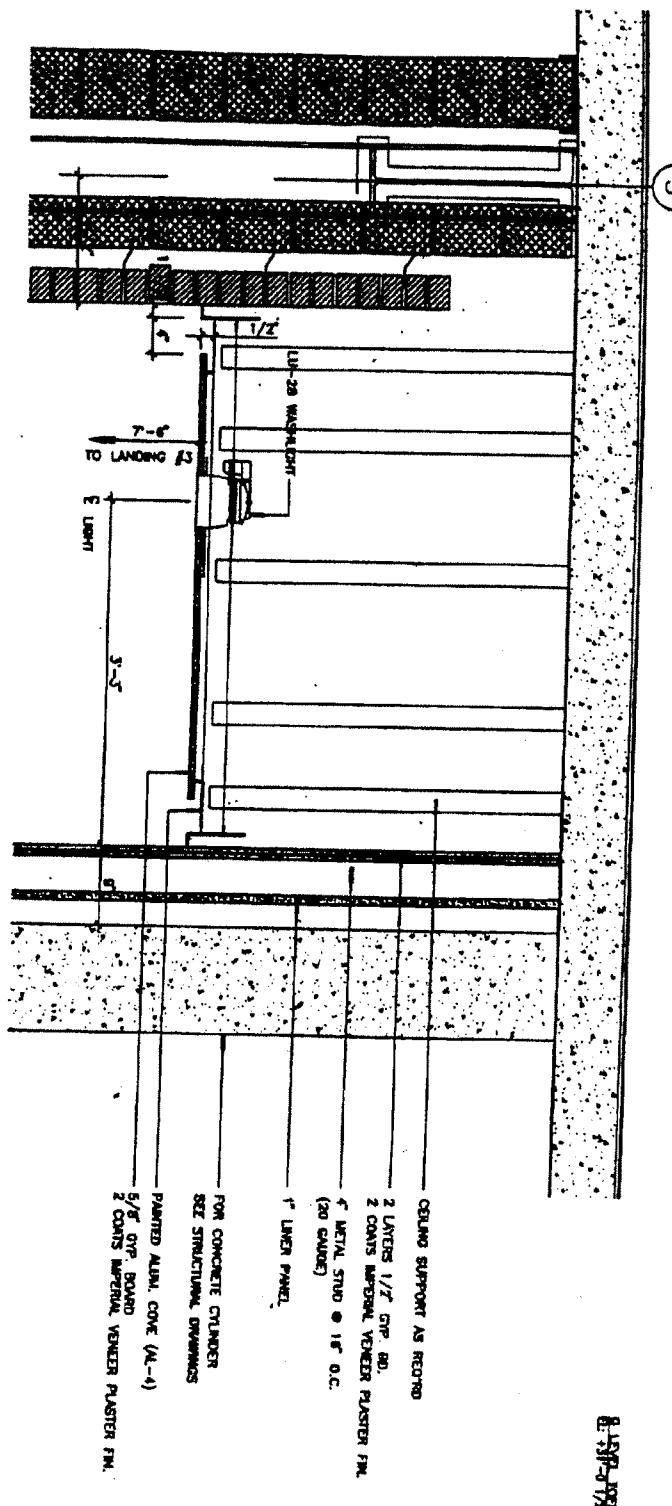

Baruch Academic Complex - Site B			ARCHITECT KPF ASSOCIATES 111 WEST 57TH STREET NEW YORK, NY 10019
55 Lexington Avenue OWNER DORMITORY AUTHORITY OF THE STATE OF NEW YORK, DA# 6500 1802 2176 1 PENNSYLVANIA PLAZA			NEW YORK, NY 10010 NEW YORK, NY 10119
NO.	REVISION	DATE	REF. DETAIL/SHEET NO. 614-656
	ADDENDUM #2 (CONTRACT #15)	3/3/98	SKETCH NO. 848

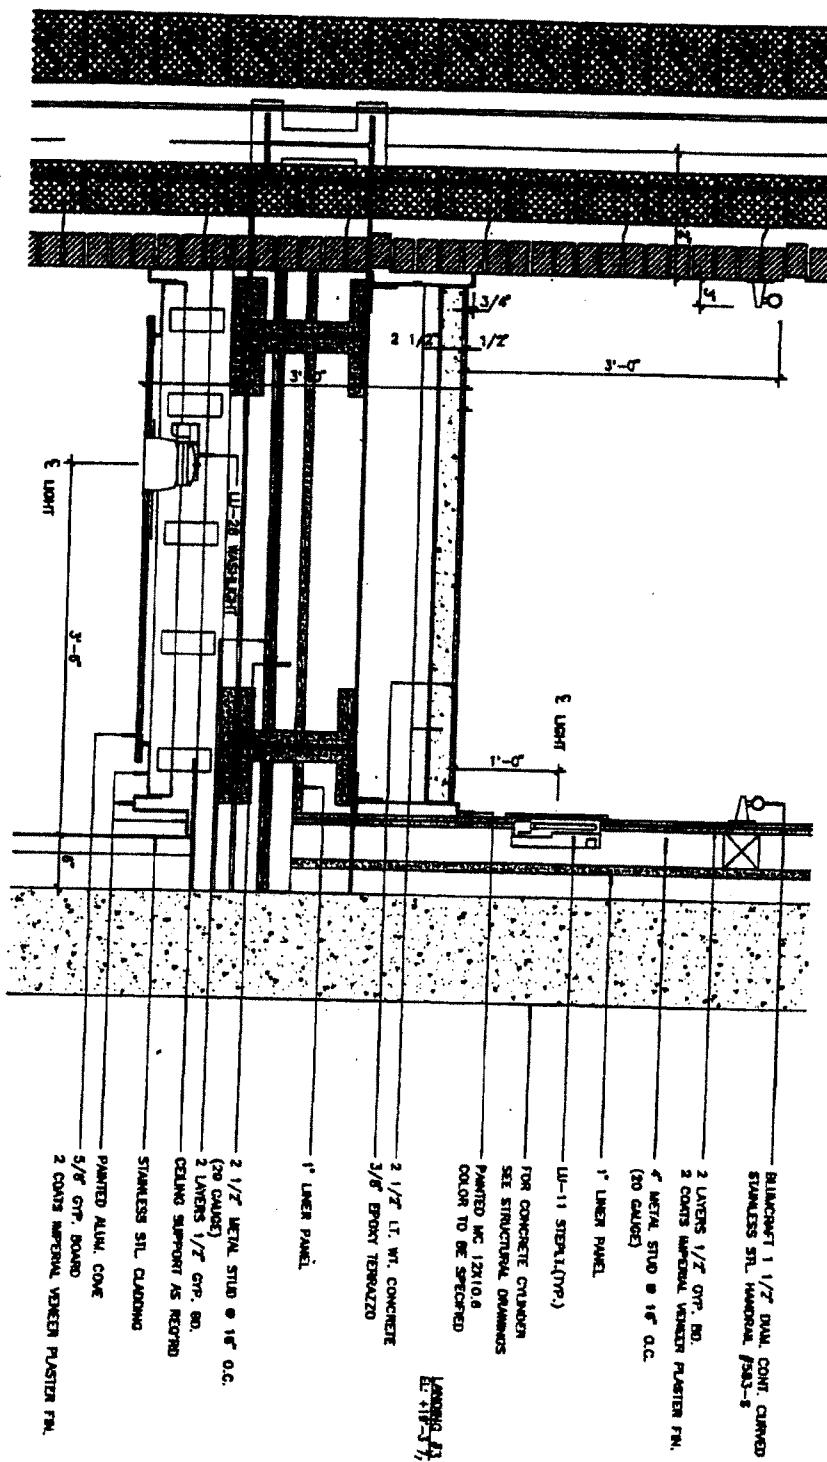

Baruch Academic Complex - Site B

55 Lexington Avenue

New York, NY 10010


ARCHITECT

KPF ASSOCIATES

111 West 57th Street
New York, NY 10019

OWNER
 DORMITORY AUTHORITY OF THE STATE OF NEW YORK, DA# 6500 1802 2176
 1 PENNSYLVANIA PLAZA
 NEW YORK, NY 10119

NO.	REVISION	DATE	REF. DETAIL/SHEET NO.	SKETCH NO.
	ADDENDUM #2 (CONTRACT #15)	3/3/98	A/A-656	849

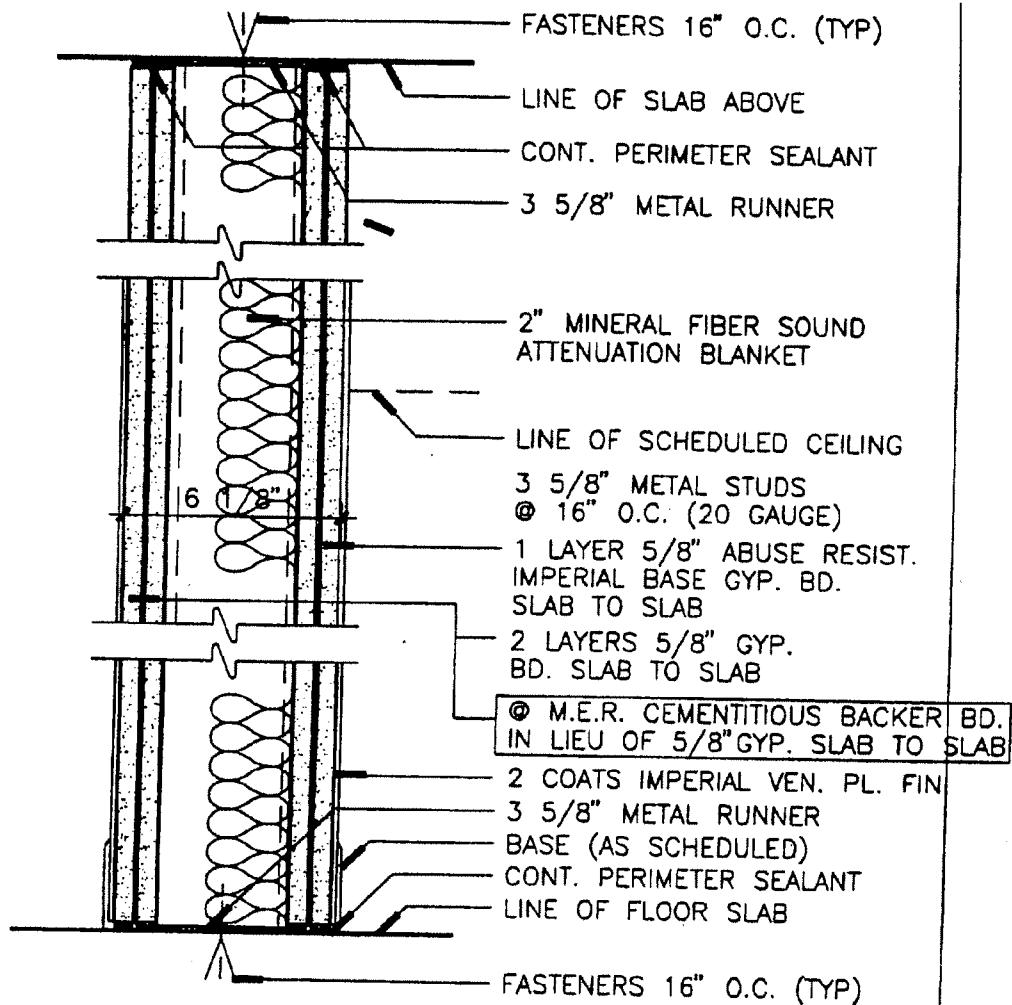

11

PARTITION (2 HR. RATING)SCALE: 3" = 1'-0" 3 5/8" MS @ 16" O.C.
UL DES. U411 BSA #301-60-SM

11G

SAME AS 11 EXCEPT
1 HOUR RATING

11H

SAME AS 11 EXCEPT ADD 3RD LAYER GYP. BOARD BEHIND
OUTER LAYER OF ABUSE RESISTANT & VEN. PLASTER
GWB. LAYER. 2 HR RATING.

11J

SAME AS 11G EXCEPT ADD 3RD LAYER GYP. BOARD BEHIND
OUTER LAYER OF ABUSE RESISTANT & VEN. PLASTER
GWB. LAYER. 1 HR RATING.**Baruch Academic Complex - Site B**

55 Lexington Avenue NEW YORK, NY 10010

OWNER

DORMITORY AUTHORITY OF THE STATE OF NEW YORK, DA# 6500 1802 2176
1 PENNSYLVANIA PLAZA NEW YORK, NY 10119ARCHITECT
KPF ASSOCIATES
111 WEST 57TH STREET
NEW YORK, NY 10019

REF. DETAIL/SHEET NO.

A-702

SKETCH NO.

SCALE

—

850


NO.

REVISION

DATE

ADDENDUM #2 (CONTRACT #15)

3/3/98

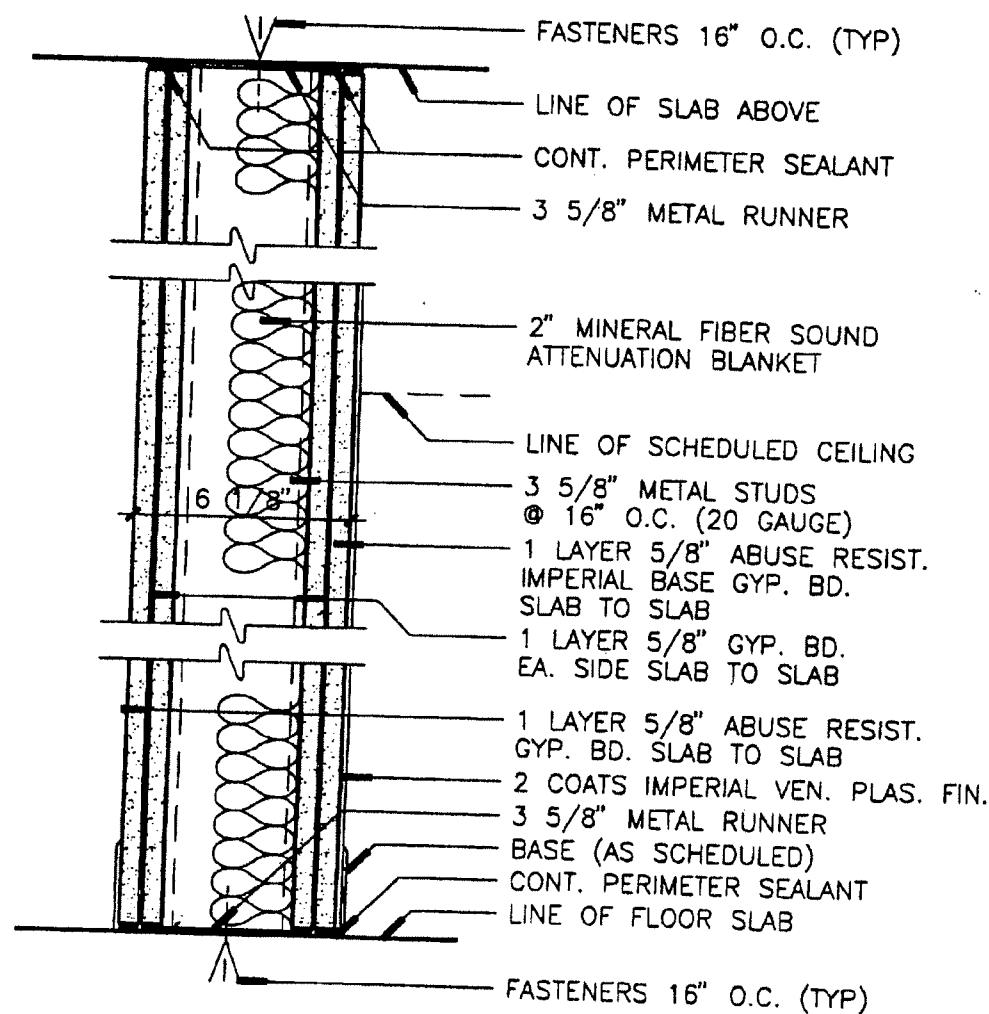

11A

PARTITION (2 HR. RATING)

3

2

SCALE: 3" = 1'-0" 3 5/8" MS @ 16" O.C.
UL DES. U411 BSA #301-60-SM

11M

SAME AS 11A EXCEPT ADD 3RD LAYER GYP. BOARD BEHIND
OUTER LAYER OF ABUSE RESISTANT & VEN. PLASTER
GWB. LAYER. 2 HR. RATING.

Baruch Academic Complex - Site B

55 LEXINGTON AVENUE NEW YORK, NY 10010

ARCHITECT
KPF ASSOCIATES
111 WEST 57TH STREET
NEW YORK, NY 10019

OWNER
DORMITORY AUTHORITY OF THE STATE OF NEW YORK, DA# 6500 1802 2176
1 PENNSYLVANIA PLAZA NEW YORK, NY 10119

REF. DETAIL/SHEET NO.

A-702

SKETCH NO.

SCALE

851


NO.

REVISION

DATE

ADDENDUM #2 (CONTRACT #15)

3/3/98

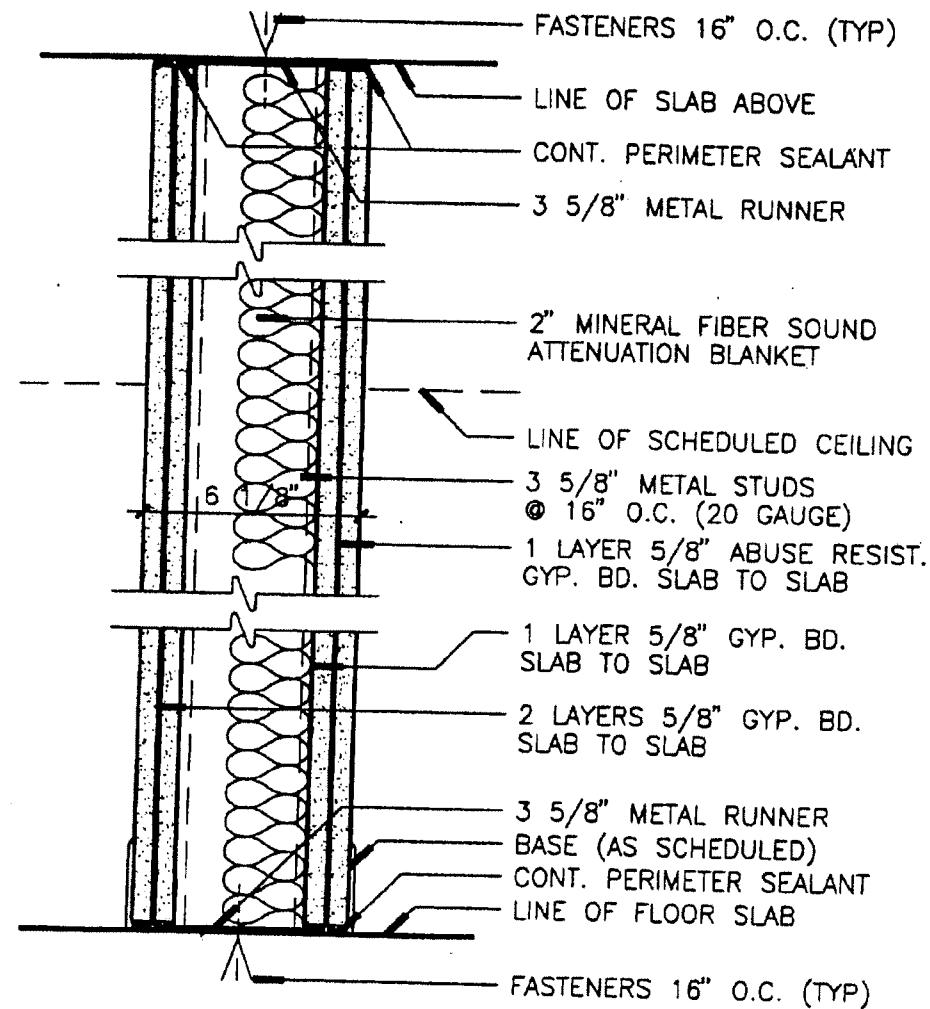

11B

PARTITION (2 HR. RATING)

SCALE: 3" = 1'-0" 3 5/8" MS @ 16" O.C.
UL DES. U411 BSA #301-60-SM2
3

Baruch Academic Complex - Site B

55 Lexington Avenue NEW YORK, NY 10010

ARCHITECT

KPF ASSOCIATES
111 WEST 57TH STREET
NEW YORK, NY 10019

OWNER

DORMITORY AUTHORITY OF THE STATE OF NEW YORK, DA# 6500 1802 2176
1 PENNSYLVANIA PLAZA NEW YORK, NY 10119

NO.

REVISION

DATE

REF. DETAIL/SHEET NO.

SKETCH NO.

ADDENDUM #2 (CONTRACT #15)


3/3/98

A-702

SCALE

—

852

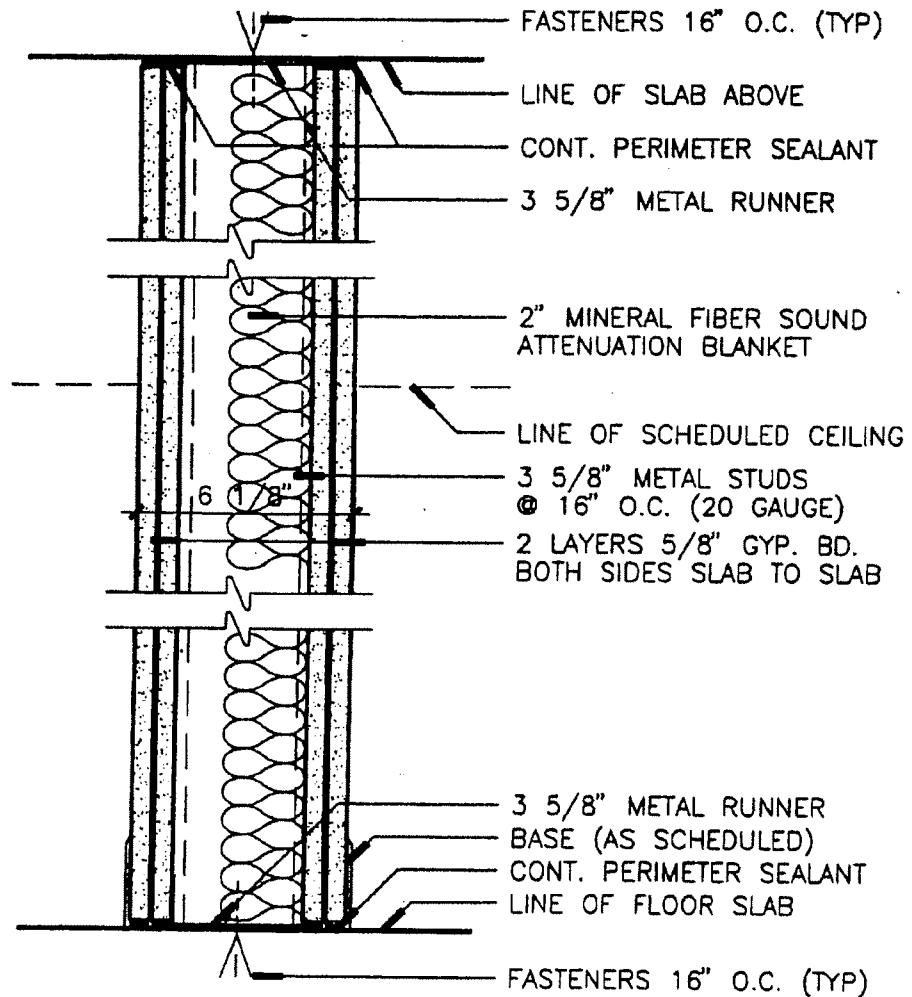

11C

PARTITION (2 HR. RATING)SCALE: 3" = 1'-0" 3 5/8" MS @ 16" O.C.
UL DES. U411 BSA #301-60-SM

Baruch Academic Complex - Site B
 55 Lexington Avenue NEW YORK, NY 10010

OWNER
 DORMITORY AUTHORITY OF THE STATE OF NEW YORK, DA# 6500 1802 2176
 1 PENNSYLVANIA PLAZA NEW YORK, NY 10119


ARCHITECT
 KPF ASSOCIATES
 111 WEST 57TH STREET
 NEW YORK, NY 10019

REF. DETAIL/SHEET NO.	SKETCH NO.
A-702	B53

NO.	REVISION	DATE
	ADDENDUM #2 (CONTRACT #15)	3/3/98

--- 08-181 NOT USED --- --- --- --- --- --- --- --- --- --- --- --- --- --- --- --- --- INCLUDES 08-181 THRU 08-184
 08-185 08-185 CONF. RM. A H.M. PT- 3'-0" 7'-0" 1-3/4 J3 H3 H.M. PT- ALUM. S ~~S~~ 1C
 08-186A 08-185 CONF. RM. A H.M. PT- 3'-0" 7'-0" 1-3/4 J3 H3 H.M. PT- ALUM. S ~~S~~ 1(A)
 08-186B 08-185 CONF. RM. A S.S. --- 3'-0" 7'-0" 1-3/4 • • S.S. --- S.S. S --- = DET. 5 / A-376
 08-186 NOT USED --- --- --- --- --- --- --- --- --- --- --- --- --- --- --- --- INCLUDES 08-186 THRU 08-189
 08-190 08-190 FET/CONF. A H.M. PT- 3'-0" 7'-0" 1-3/4 J5 H3 H.M. PT- ALUM. S S OTM
 08-191 NOT USED --- --- --- --- --- --- --- --- --- --- --- --- --- --- --- --- INCLUDES 08-191 THRU 08-197
 08-198 08-198 SERV. LOBBY S H.M. PT- 6'-0" 7'-0" 1-3/4 J3 H3 H.M. PT- ALUM. S S 26

Baruch Academic Complex - Site B		ARCHITECT KPF ASSOCIATES 111 WEST 57TH STREET NEW YORK, NY 10019
55 LEXINGTON AVENUE	NEW YORK, NY 10010	
OWNER DORMITORY AUTHORITY OF THE STATE OF NEW YORK, DA• 6500 1802 2176 1 PENNSYLVANIA PLAZA NEW YORK, NY 10119		REF. DETAIL/SHEET NO. A-714
NO.	REVISION	DATE
ADDENDUM (CONTRACT #15)		SCALE N.A.
		SKETCH NO. 854

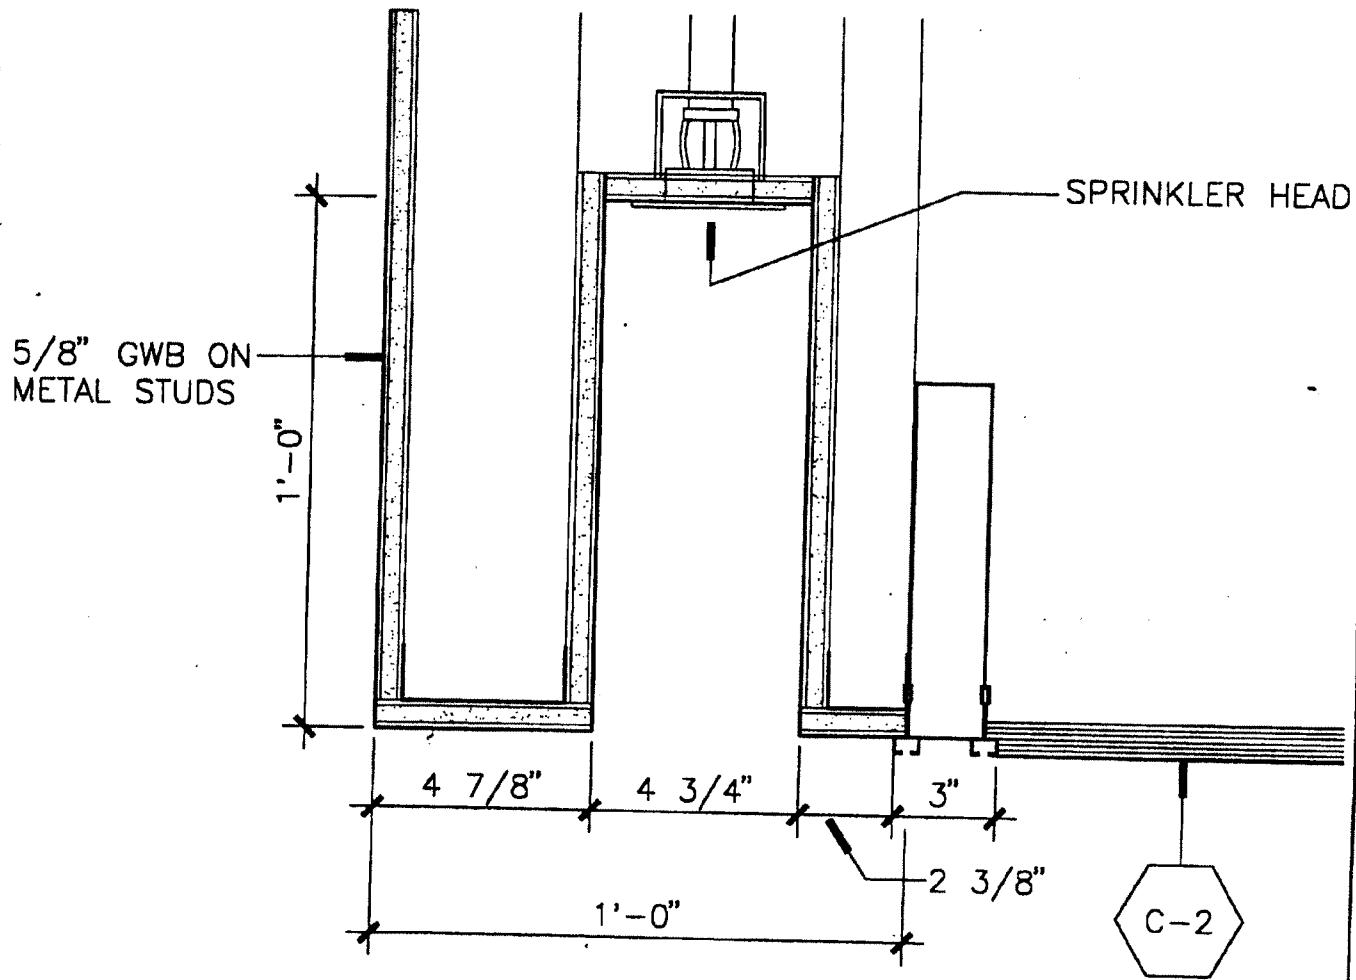

1

SPRINKLER POCKET AT DIFFUSER


3" = 1'-0"

Baruch Academic Complex - Site B
 55 LEXINGTON AVENUE NEW YORK, NY 10010
 OWNER
 DORMITORY AUTHORITY OF THE STATE OF NEW YORK, DA# 6500 1802 2176
 1 PENNSYLVANIA PLAZA NEW YORK, NY 10119

ARCHITECT
 KPF ASSOCIATES
 111 WEST 57TH STREET
 NEW YORK, NY 10019

NO.	REVISION	DATE
ADDENDUM #2 (CONTRACT #15)		3/3/98

REF. DETAIL/SHEET NO. 1/A-739	SKETCH NO. 855
SCALE 3" = 1'-0"	

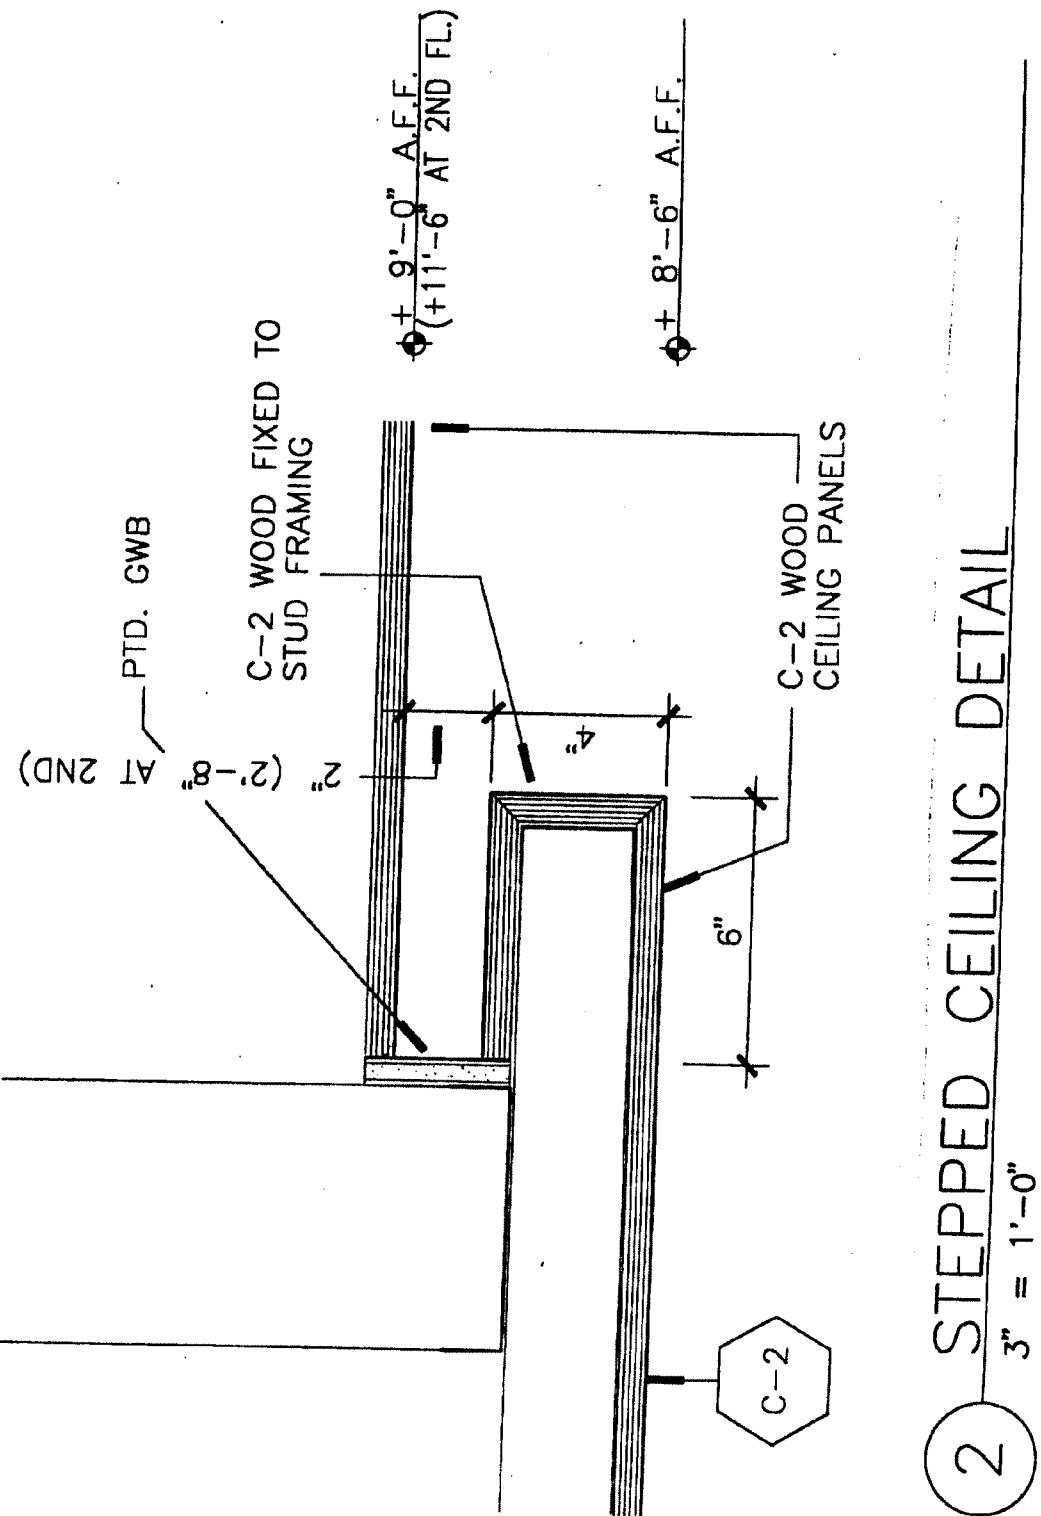
Baruch Academic Complex - Site B


55 LEXINGTON AVENUE NEW YORK, NY 10010

OWNER
DORMITORY AUTHORITY OF THE STATE OF NEW YORK, DA# 6500 1802 2176
1 PENNSYLVANIA PLAZA NEW YORK, NY 10119

ARCHITECT
KPF ASSOCIATES
111 WEST 57TH STREET
NEW YORK, NY 10019

REF. DETAIL SHEET NO.	SKETCH NO.
2/A-730	856
SCALE	
3'-0 1'-0"	

NO.	REVISION	DATE
ADDENDUM #2 (CONTRACT #15)		3/3/98

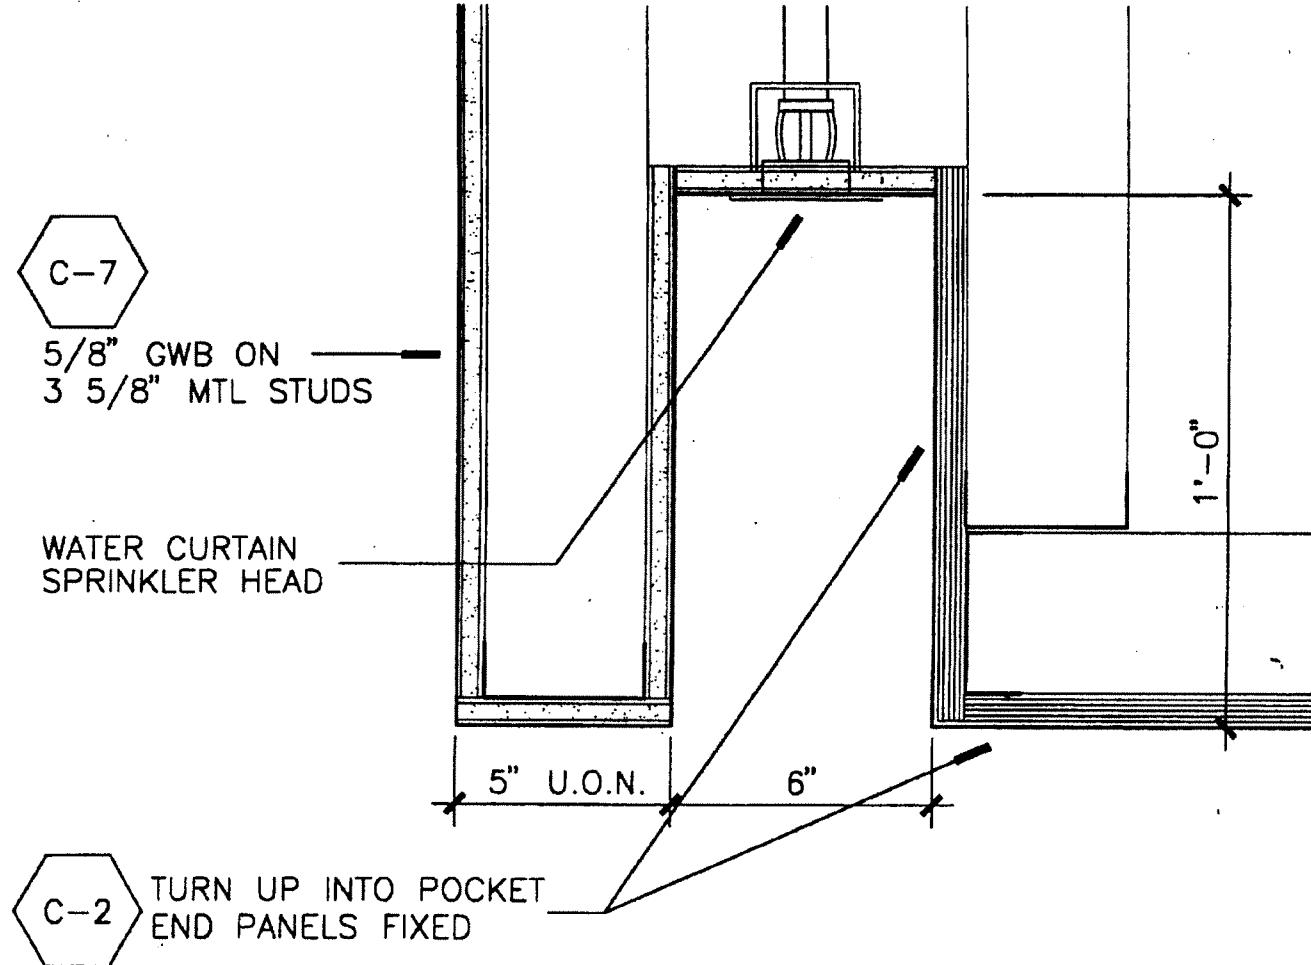

3

RECESSED WATER CURTAIN

3" = 1'-0"

Baruch Academic Complex - Site B

55 LEXINGTON AVENUE NEW YORK, NY 10010

OWNER

DORMITORY AUTHORITY OF THE STATE OF NEW YORK, DA# 6500 1802 2176
1 PENNSYLVANIA PLAZA NEW YORK, NY 10119

NO.

REVISION

DATE

ADDENDUM #2 (CONTRACT #15)

3/3/98

ARCHITECT

KPF ASSOCIATES
111 WEST 57TH STREET
NEW YORK, NY 10019


REF. DETAIL/SHEET NO.

3/A-739

SKETCH NO.

857

SCALE
3"=1'-0"

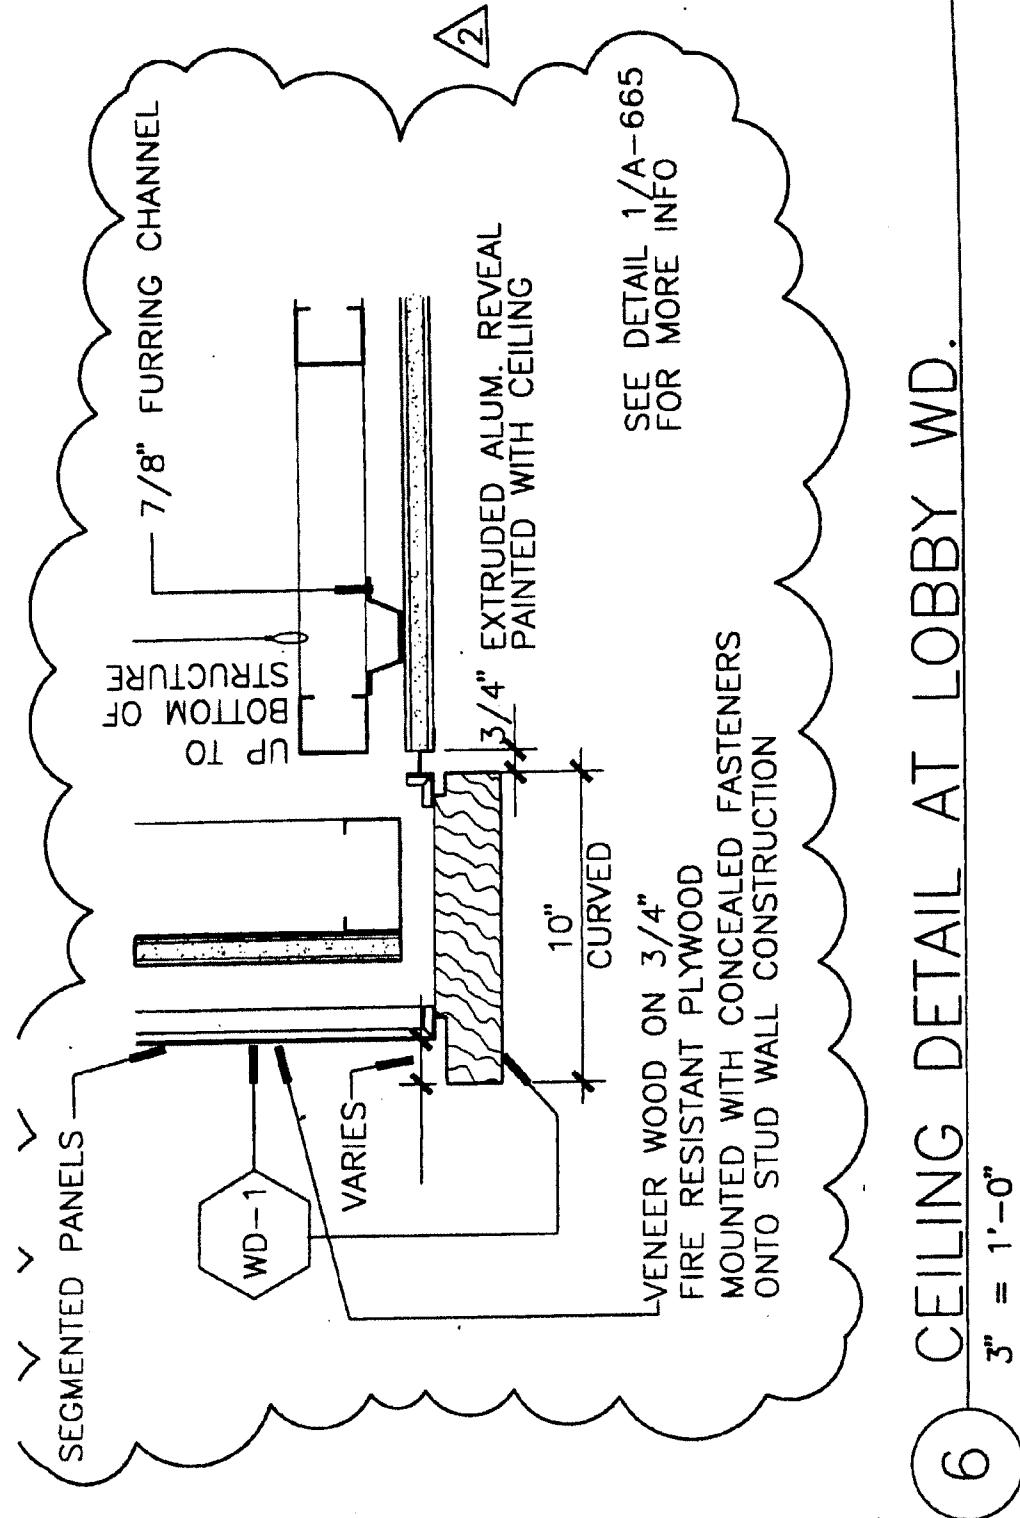

Baruch Academic Complex - Site B

55 LEXINGTON AVENUE

NEW YORK, NY 10010

OWNER

DORMITORY AUTHORITY OF THE STATE OF NEW YORK, DA# 6500 1802 2176
1 PENNSYLVANIA PLAZA NEW YORK, NY 10119

NO.

REVISION

DATE

ADDENDUM #2 (CONTRACT #15)

3/3/98

ARCHITECT

KPF ASSOCIATES
111 WEST 57TH STREET
NEW YORK, NY 10019

REF. DETAIL/SHEET NO.


6/A-737

SCALE


—

SKETCH NO.


871

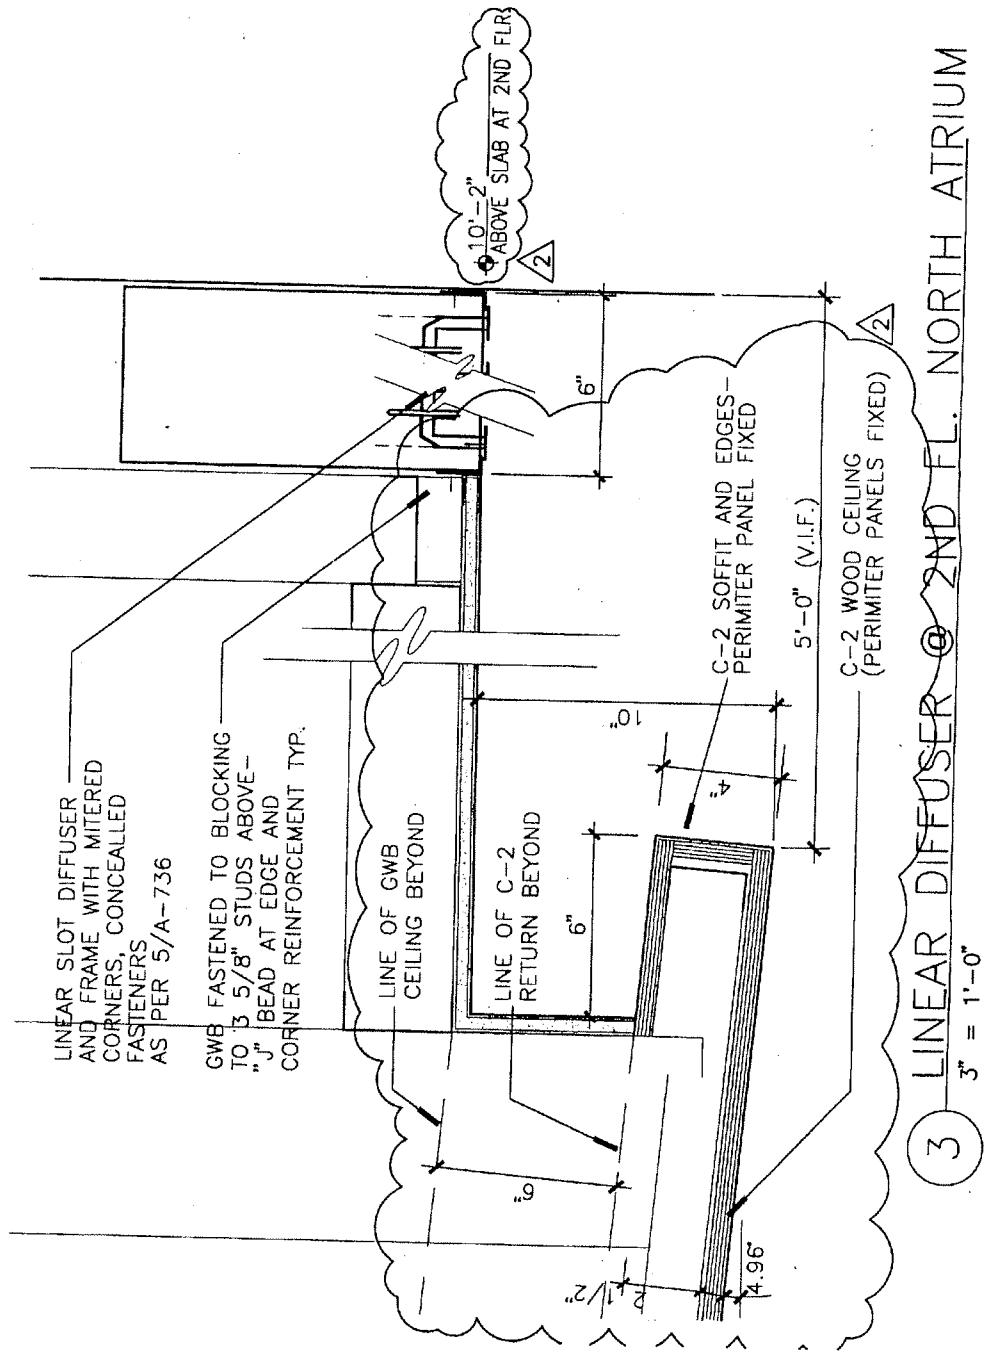


Baruch Academic Complex - Site B			ARCHITECT KPF ASSOCIATES 111 WEST 57TH STREET NEW YORK, NY 10019
55 Lexington Avenue OWNER DORMITORY AUTHORITY OF THE STATE OF NEW YORK, DA# 6500 1B02 2176 1 PENNSYLVANIA PLAZA NEW YORK, NY 10119			REF. DETAIL/SHEET NO. 3/A-737
NO.	REVISION	DATE	SKETCH NO. 868
		3/3/98	3"-1"-0"

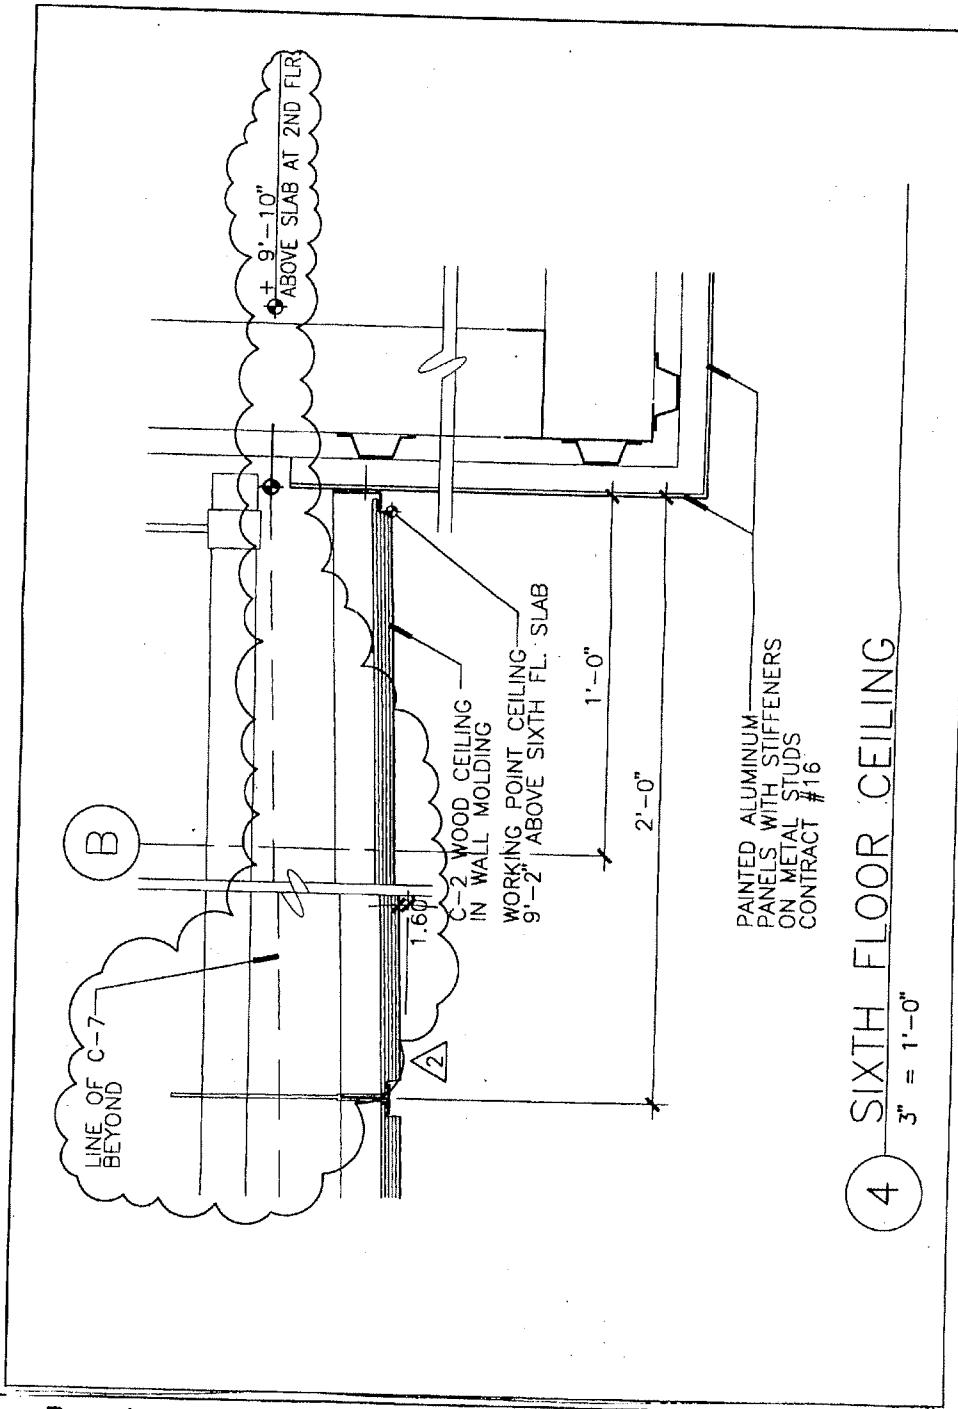


Baruch Academic Complex - Site B			ARCHITECT KPF ASSOCIATES 111 WEST 57TH STREET NEW YORK, NY 10019
55 Lexington Avenue NEW YORK, NY 10010 OWNER DORMITORY AUTHORITY OF THE STATE OF NEW YORK, DA# 6500 1802 2176 1 PENNSYLVANIA PLAZA NEW YORK, NY 10119			REF. DETAIL SHEET NO. 4/A-737
NO.	REVISION	DATE	SKETCH NO. 869
		3/3/98	SCALE 3"-1'-0"
ADDENDUM #2 (CONTRACT #15)			

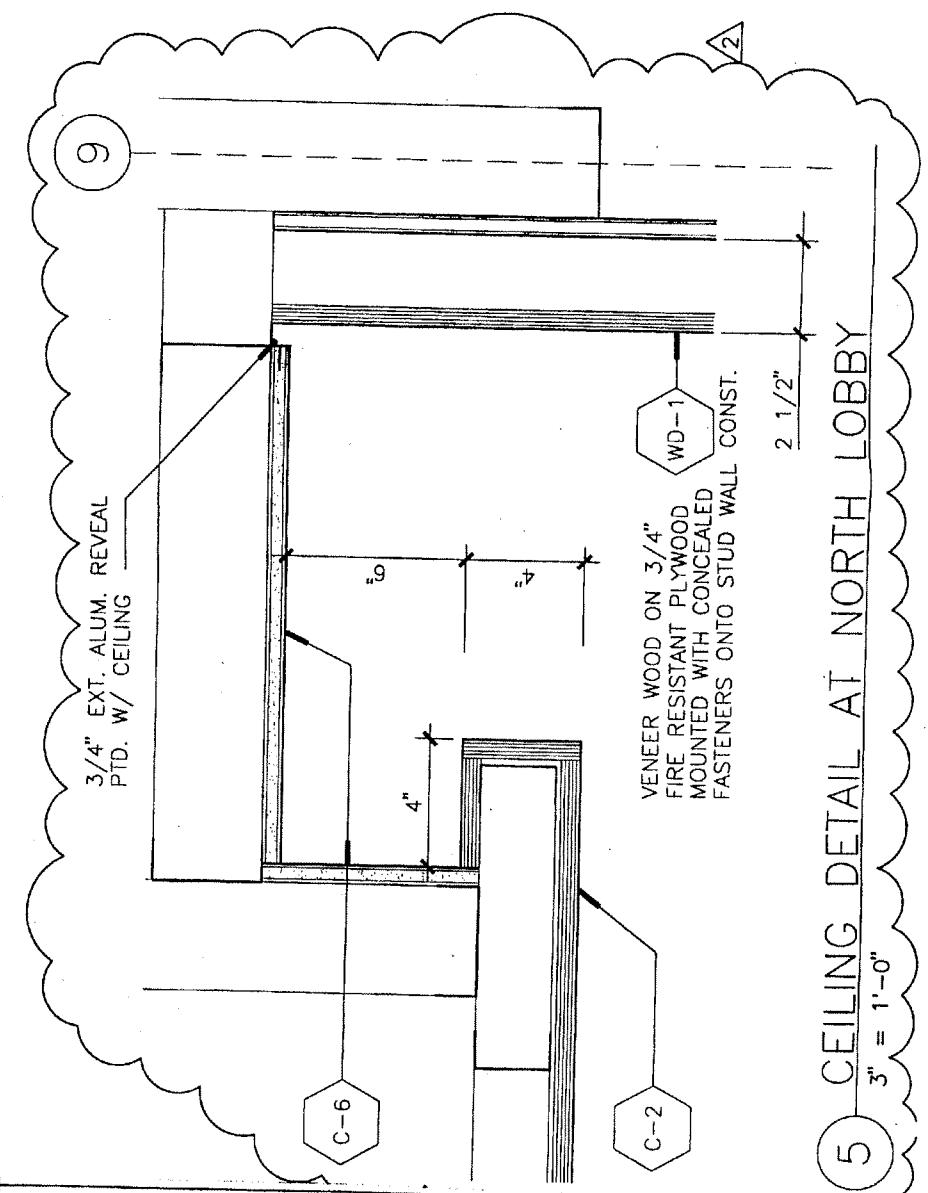


Baruch Academic Complex - Site B			ARCHITECT
55 LEXINGTON AVENUE	NEW YORK, NY 10010	OWNER	KPF ASSOCIATES 111 WEST 57TH STREET NEW YORK, NY 10019
DORMITORY AUTHORITY OF THE STATE OF NEW YORK, DA# 6500 1802 2176 1 PENNSYLVANIA PLAZA			REF. DETAIL SHEET NO.
NO.	REVISION	DATE	SKETCH NO.
		3/3/98	5/4737
			SCALE 3" = 1'-0"
ADDENDUM #2 (CONTRACT #15)			870

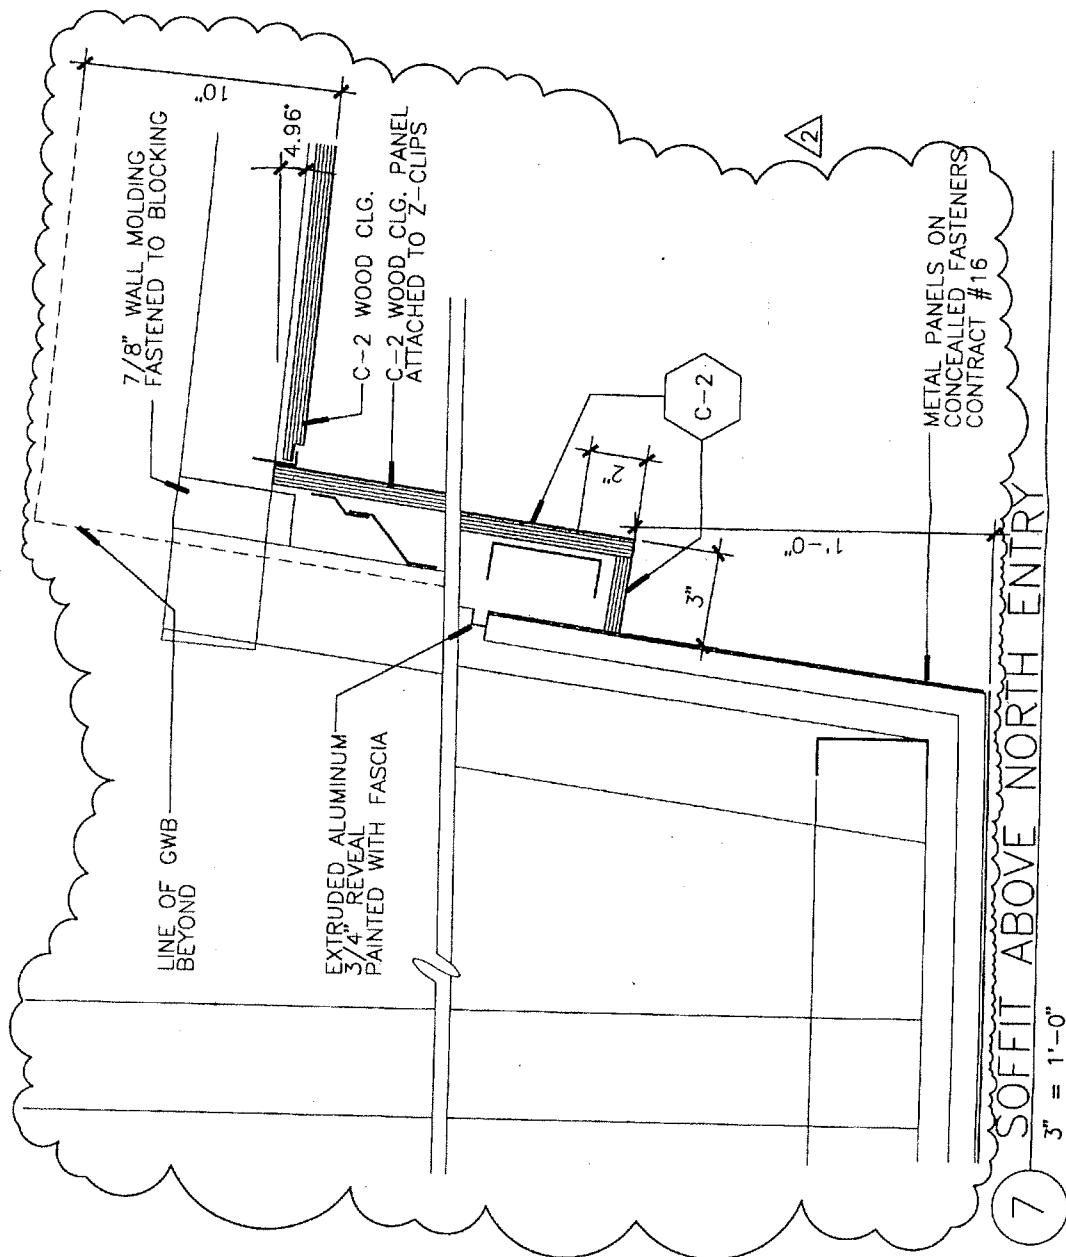


Baruch Academic Complex - Site B			ARCHITECT KPF ASSOCIATES 111 WEST 57TH STREET NEW YORK, NY 10019
55 LEXINGTON AVENUE OWNER DORMITORY AUTHORITY OF THE STATE OF NEW YORK, DA# 6500 1802 2178 1 PENNSYLVANIA PLAZA NEW YORK, NY 10119			REF. DETAIL/SHEET NO. 7/A-737
NO.	REVISION	DATE	SKETCH NO. 872
		3/3/98	SCALE 3"=1'-0"
ADDENDUM #2 (CONTRACT #15)			

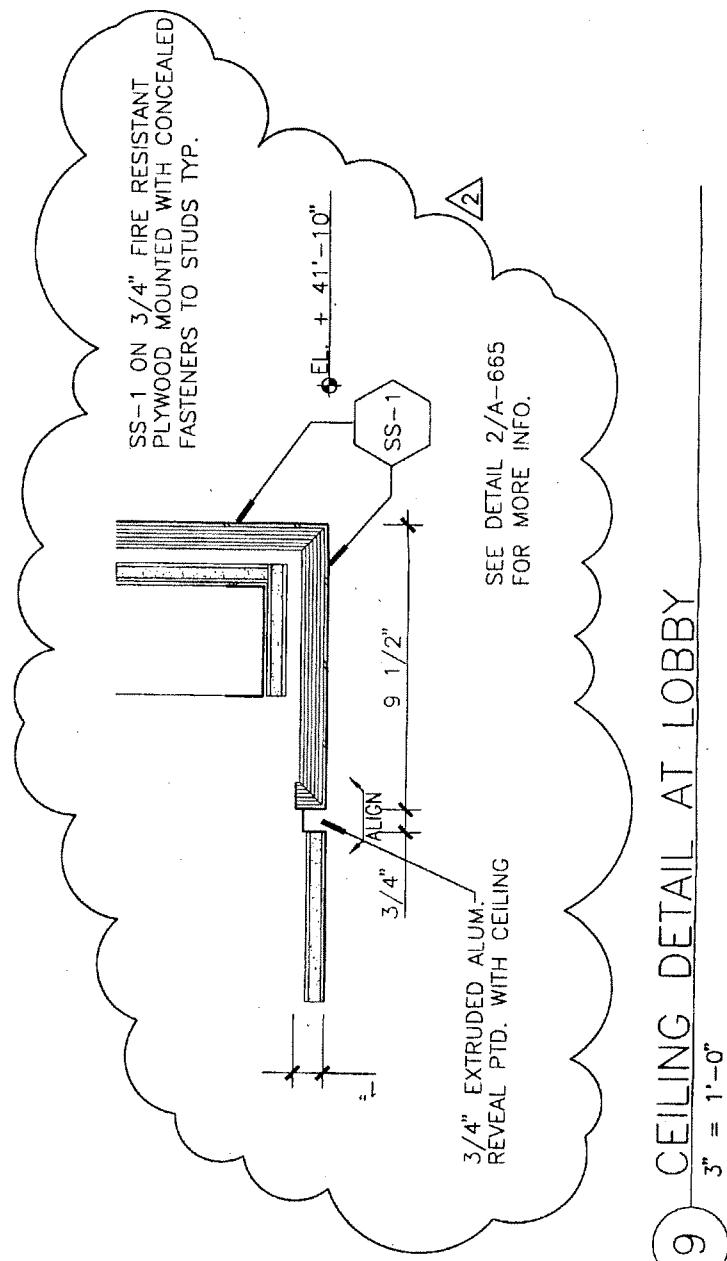


Baruch Academic Complex - Site B			ARCHITECT
55 Lexington Avenue	NEW YORK, NY 10010	KPF ASSOCIATES	
OWNER		111 WEST 57TH STREET	
DORMITORY AUTHORITY OF THE STATE OF NEW YORK, DA# 6500 1802 2178		NEW YORK, NY 10019	
1 PENNSYLVANIA PLAZA	NEW YORK, NY 10119	REF. DETAIL SHEET NO.	SKETCH NO.
NO.	REVISION	9/A-737	873
ADDENDUM #2 (CONTRACT #15)		SCALE	3'-1"-0"
3/3/98			

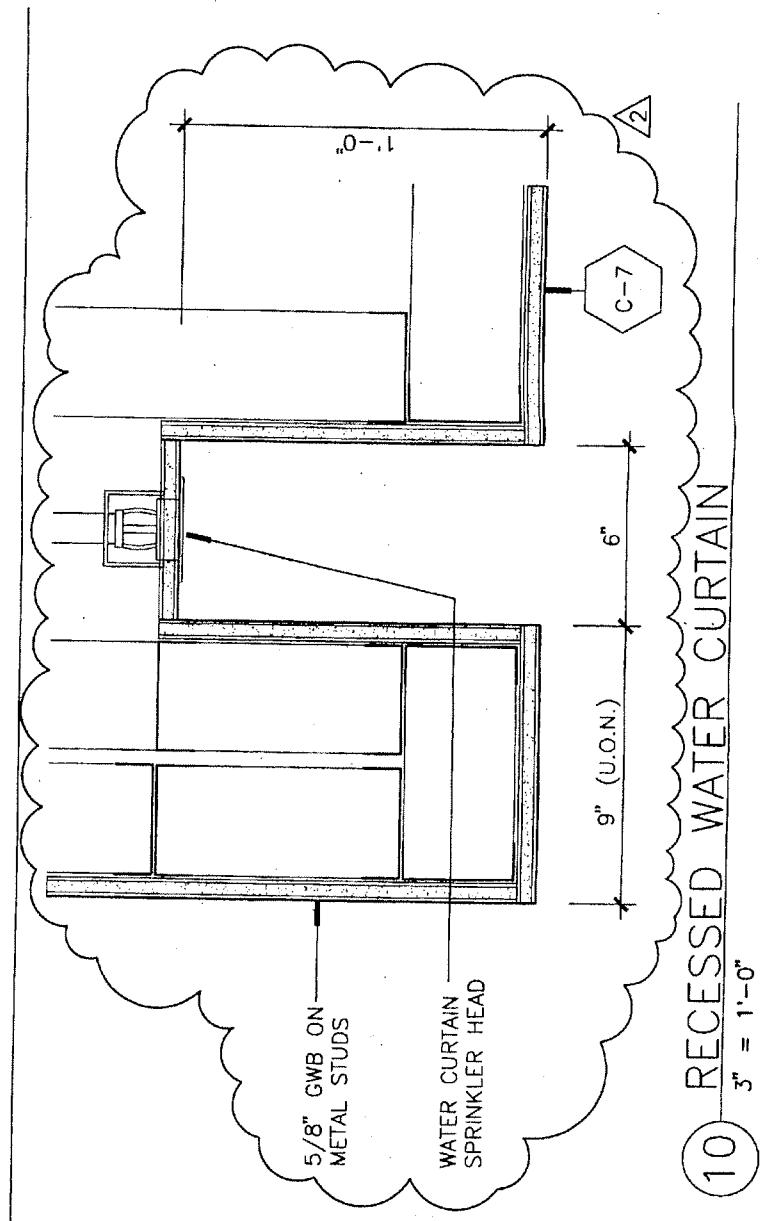


Baruch Academic Complex - Site B			ARCHITECT
55 Lexington Avenue NEW YORK, NY 10010			KPF ASSOCIATES 111 WEST 57TH STREET NEW YORK, NY 10019
OWNER DORMITORY AUTHORITY OF THE STATE OF NEW YORK, DA# 6500 1802 2176 1 PENNSYLVANIA PLAZA NEW YORK, NY 10119			REF. DETAIL/SHEET NO.
NO.	REVISION	DATE	SKETCH NO.
ADDENDUM #2 (CONTRACT #15) 3/3/98			SCALE 5" = 1'-0" 874

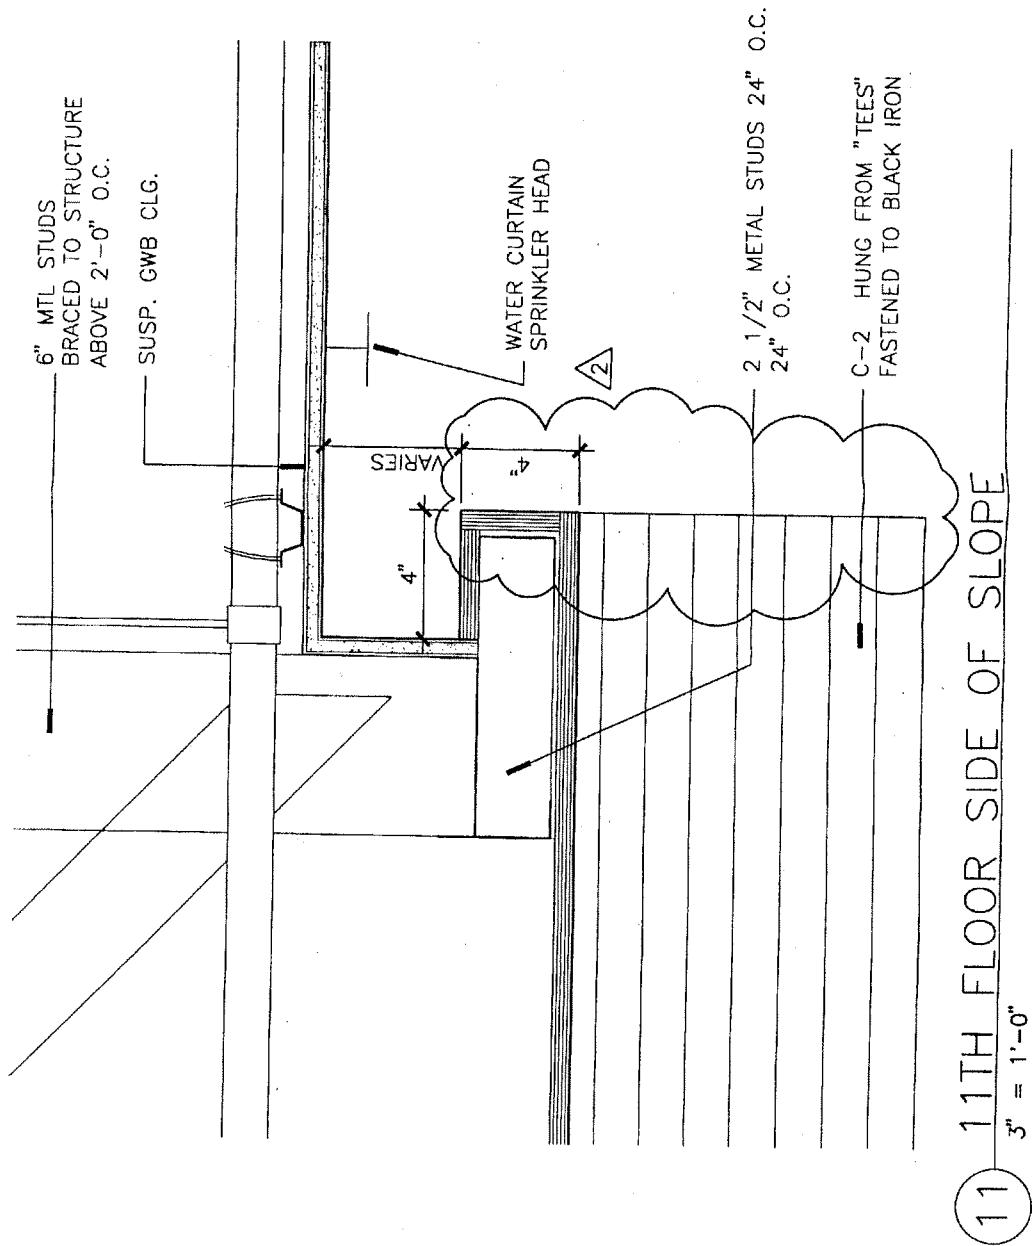


Baruch Academic Complex - Site B			ARCHITECT
55 LEXINGTON AVENUE	NEW YORK, NY 10010	KPF ASSOCIATES	
OWNER			111 WEST 57TH STREET
DORMITORY AUTHORITY OF THE STATE OF NEW YORK, DA# 6500 1802 2176	1 PENNSYLVANIA PLAZA	NEW YORK, NY 10019	NEW YORK, NY 10019
NO.	REVISION	DATE	REF. DETAIL/SHEET NO.
		3/3/98	11/A-737
			SKETCH NO.
			875
			SCALE 3" = 1'-0"
ADDENDUM #2 (CONTRACT #15)			

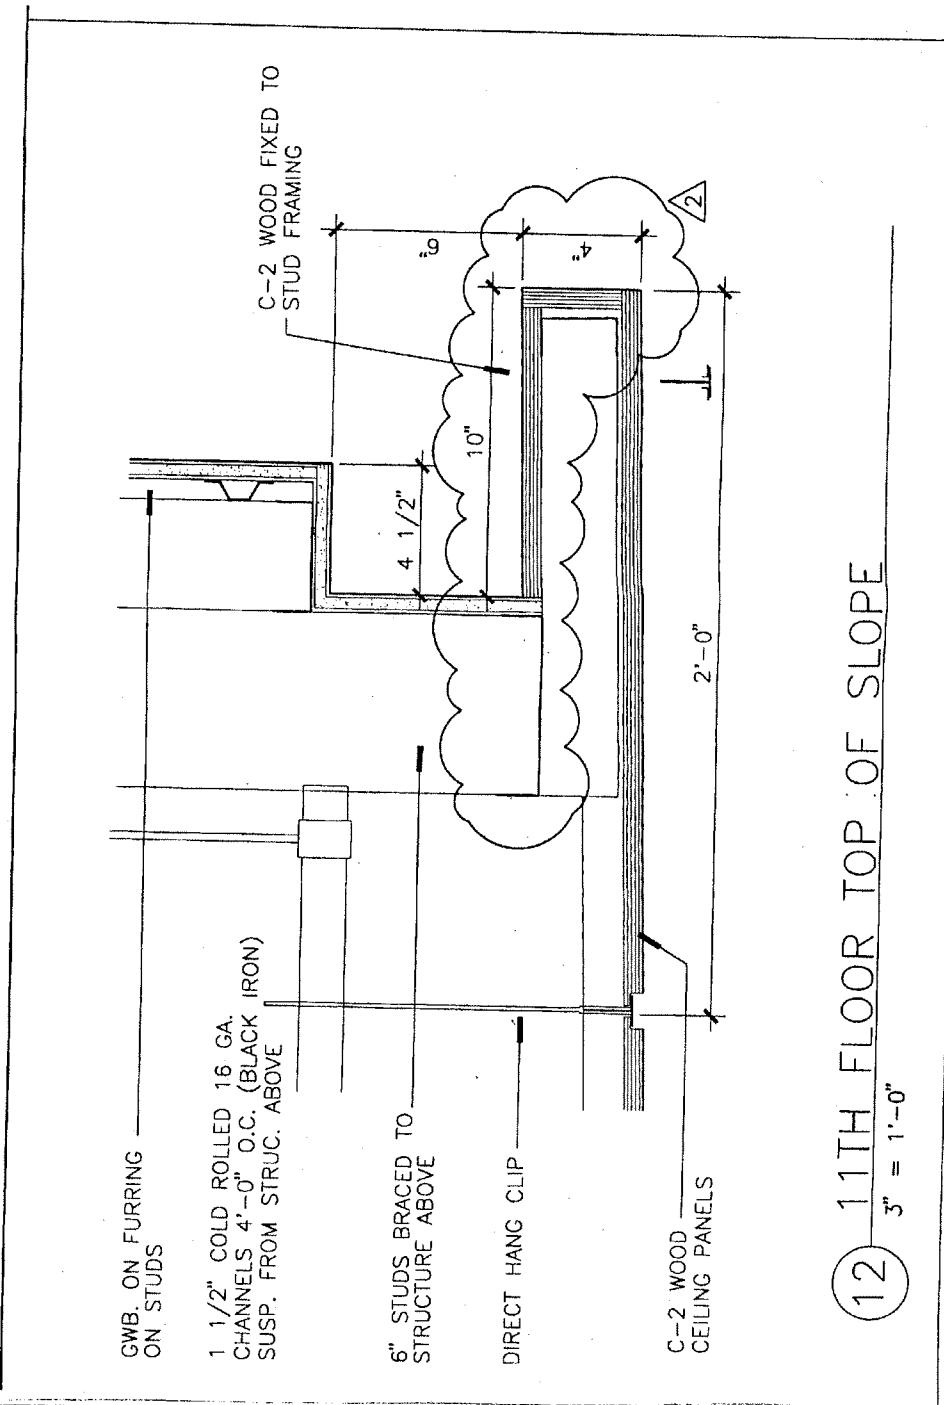


Baruch Academic Complex - Site B 55 LEXINGTON AVENUE NEW YORK, NY 10010			ARCHITECT KPF ASSOCIATES 111 WEST 57TH STREET NEW YORK, NY 10019
OWNER DORMITORY AUTHORITY OF THE STATE OF NEW YORK, DA# 6500 1802 2176 1 PENNSYLVANIA PLAZA NEW YORK, NY 10119			REF. DETAIL SHEET NO. 12/A-737
NO.	REVISION	DATE	SKETCH NO. 876
		3/3/98	SCALE 3" = 1'-0"

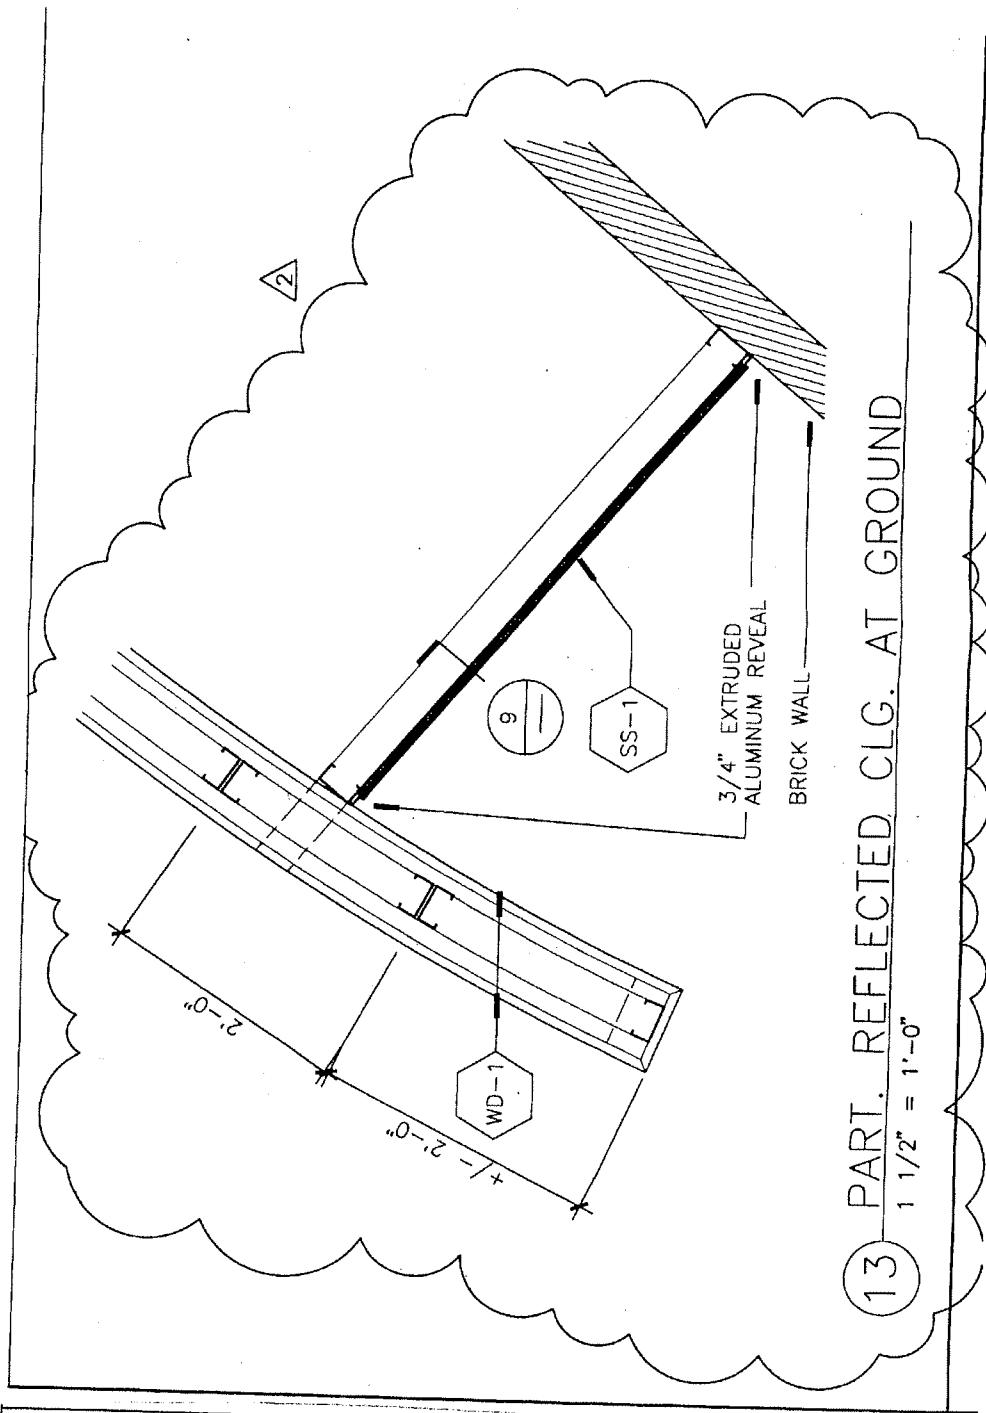

Baruch Academic Complex - Site B			ARCHITECT
55 Lexington Avenue NEW YORK, NY 10010			KPF ASSOCIATES 111 WEST 57TH STREET NEW YORK, NY 10019
OWNER DORMITORY AUTHORITY OF THE STATE OF NEW YORK, DA# 6500 1802 2176 1 PENNSYLVANIA PLAZA NEW YORK, NY 10119			REF. DETAIL/SHEET NO. 13/A-737
NO.	REVISION	DATE	SKETCH NO. 877
ADDENDUM #2 (CONTRACT #15)			SCALE 3'-0"

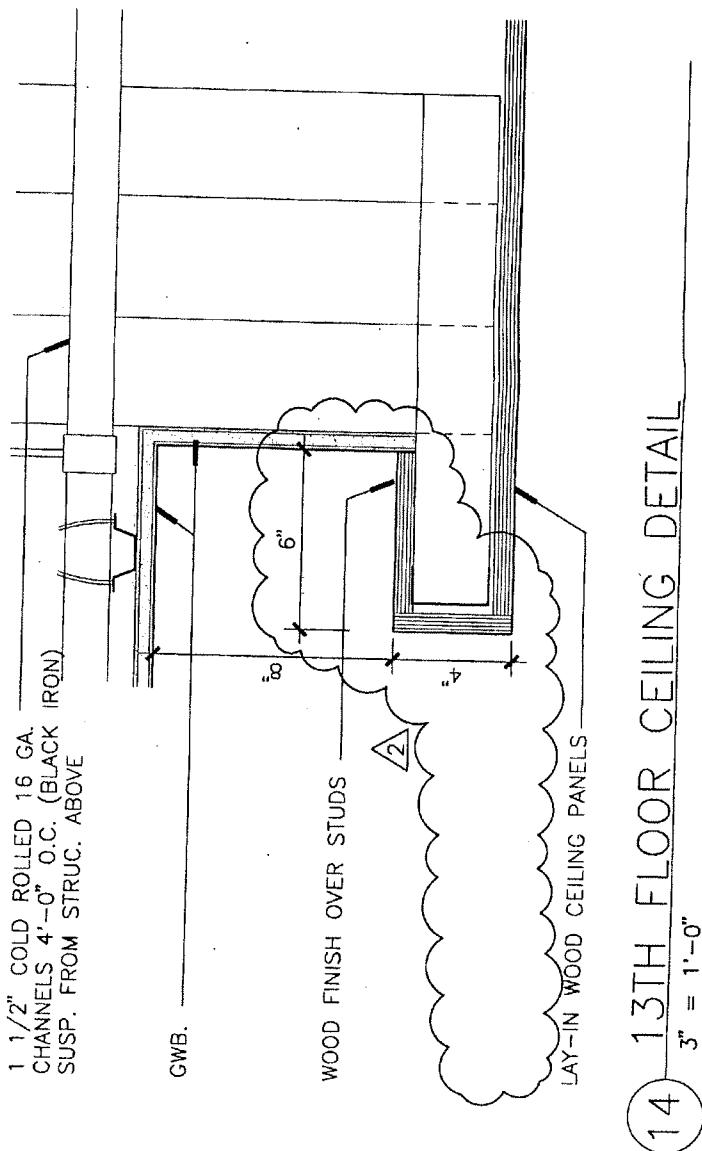

Baruch Academic Complex - Site B			ARCHITECT
55 Lexington Avenue NEW YORK, NY 10010			KPF ASSOCIATES 111 WEST 57TH STREET NEW YORK, NY 10019
OWNER	DORMITORY AUTHORITY OF THE STATE OF NEW YORK, DA# 6500 1802 2176 1 PENNSYLVANIA PLAZA NEW YORK, NY 10119	REF. DETAIL SHEET NO.	SKETCH NO.
NO.	REVISION	J	14/A-737
	ADDENDUM #2 (CONTRACT #15)	DATE	878
		3' = 1'-0"	

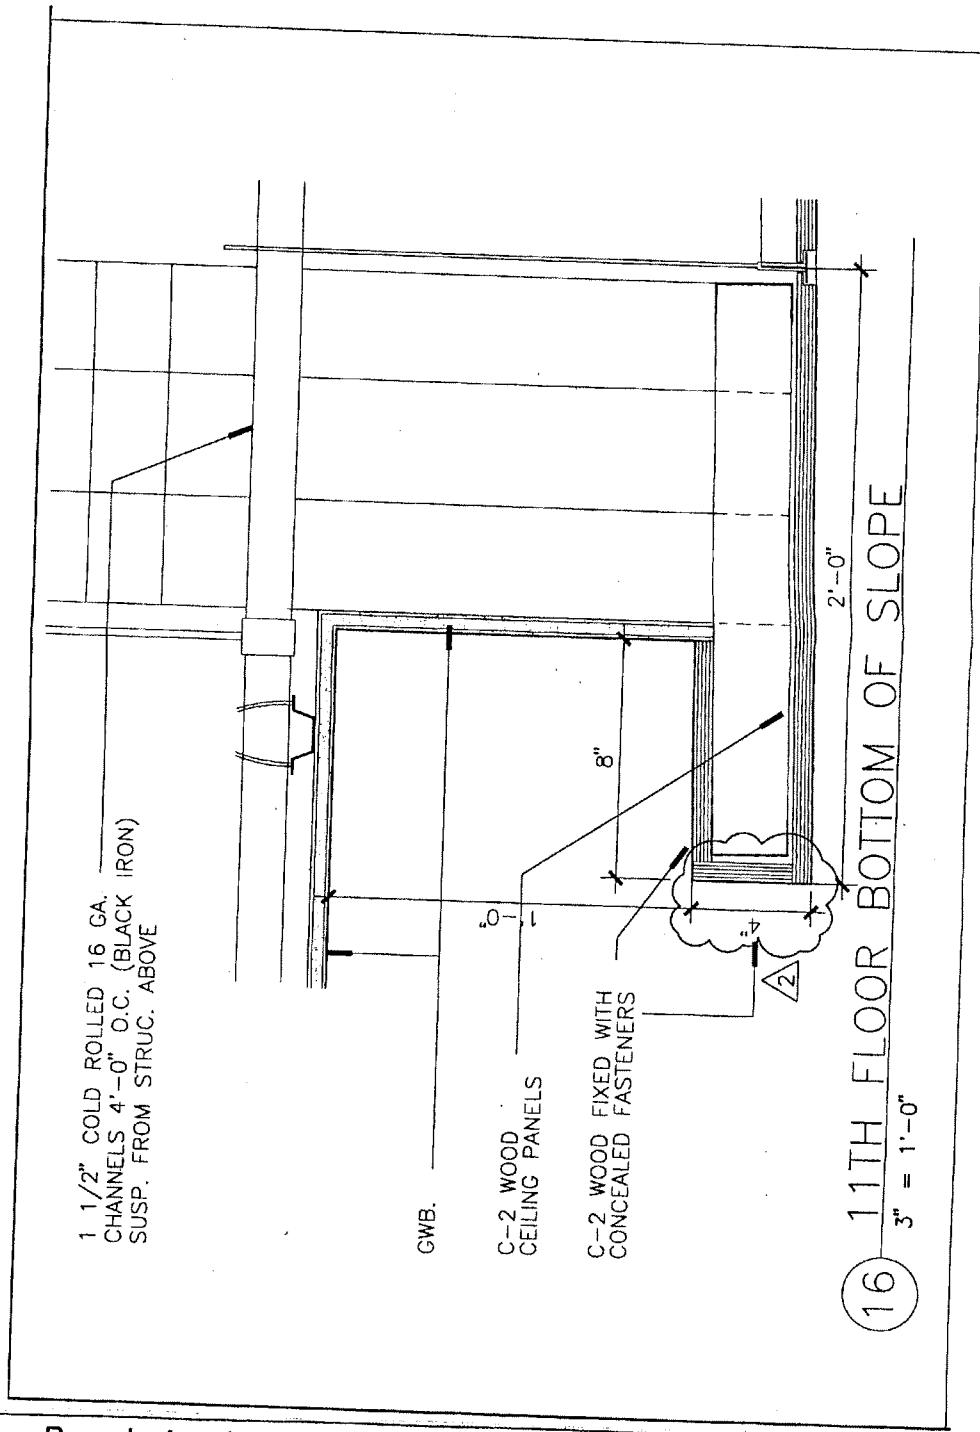

Baruch Academic Complex - Site B			ARCHITECT
55 LEXINGTON AVENUE	NEW YORK, NY 10010	KPF ASSOCIATES	
OWNER		111 WEST 57TH STREET	
DORMITORY AUTHORITY OF THE STATE OF NEW YORK, DA# 6500 1802 2178		NEW YORK, NY 10019	
1 PENNSYLVANIA PLAZA	NEW YORK, NY 10119	REF. DETAIL SHEET NO.	SKETCH NO.
NO.	REVISION	16/A-737	879
ADDENDUM #2 (CONTRACT #15)		SCALE	3"=1'-0"